

USDA-FOREST SERVICE

Index File No. Z-21

CORNER RECORD (SEARCH)

(Ref. FSM 7151.4)

Tract or Survey No. _____ Cor. No. Z-21


T 35 R. 30E

R.D. UK196 County _____

Merid. _____

N.F. _____ State _____

CORNER DIAGRAM

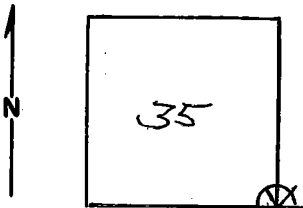

DESCRIBE CORNER MONUMENT FOUND

Stone. Approx. Call Size. Lies in base of a clump of brush, approx. 12 ft. north of a fence which runs erratically East and West.

DESCRIBE BEARING TREES OR OTHER OFFICIAL ACCESSORIES FOUND

Stumps of the NW and NE B.T.'s have visible scribing. The SW and SE B.T.'s are living. The S.W. has visible scribing. The S.E. has a burned out scar facing the stone. I placed B.T. Tass on all 4 and Attention Posters on the 2 living trees.

PHOTO IDENTIFICATION DATA

Photo No. _____
 Filed At. _____
 Object Ident. _____
 Ident. By _____
 Signature

DESCRIBE CORNER LOCATION RELATIVE TO NEAR-BY FEATURES, ALSO HOW TO REACH CORNER

Location is on a bench which slopes gently N.W. It is about 450 ft. east of a stream and about 700 ft. east of where a primitive road passes thru the fence. I placed a location poster at the road and fence junction.

PLANE COORDINATE POSITION DATA

State _____ Zone _____
 X _____
 Y _____
 Estab. By _____
 Agency

Signature T. Hollam

Title _____ Division _____ Headquarters _____

Date 4-28-80 7100-52-(3/68)

CORNER RECORD (PERPETUATION)

MONUMENT: DESCRIBE NEW MONUMENT SET, OR WORK DONE TO PRESERVE EXISTING MONUMENT

ACCESSORIES : DESCRIBE NEW BT's WITNESS OBJECTS ETC. ESTABLISHED, OR WORK DONE TO PRESERVE EXISTING EVIDENCE

Work Done By _____ Title _____ Date _____ State Registration No. _____
or Agency _____
Certified Cor. Record Prepared ? Yes No Filed At: _____ Date _____

REMARKS

Index File No. _____ T. _____ R. _____ M. _____ Tract or Surv. No. _____ Cor. _____
U.S. G.P.O. 1977-725-576/586