

OREGON CORNER RESTORATION FORM

P-11

Section 21 Township 3S Range 31E
County Umatilla Date: May 2, 2015

Corner Designation: 3S31P11

Condition Report Only
Not found
Remonumented
Unrecorded
x Surveyed in
x Referenced out

Center Quarter corner of Section 21, T3S, R31E,
W.M., Umatilla County, Oregon.


Previous Renewals / Surveys, etc.

A position was computed in Umatilla County Survey 97-104-B but not monumented. This corner point is based on the found monumentation from that survey.

Monument and Accessories found: (condition and source)
None.

DIAGRAM

SKETCH

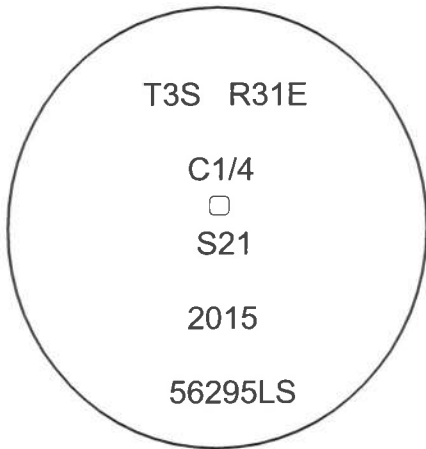

MONUMENT (S) AND ACCESSORIES SET (Procedures and Description)

At the intersection of the east - west and north - south centerlines I set a 1 1/2" x 30" galvanized iron pipe with a 2 1/4" brass cap attached 30 inches in the ground with the cap stamped as shown in the diagram above.

For references, I set four 5/8" by 24" rebars with 1 1/8" orange plastic caps stamped WTS and 56295LS as described below:

- an iron rebar bears S45°16'33"W, 25.60 feet, 4 inches below the surface;
- an iron rebar bears N41°48'34"W, 25.78 feet, 4 inches below the surface;
- an iron rebar bears N47°05'10"E, 25.75 feet, 4 inches below the surface;
- an iron rebar bears S40°54'58"E, 26.99 feet, 4 inches below the surface;

The monument and references were tied using a Trimble R7/R8 RTK GPS.

Location and comments

Compass Declination

Surveyors Seal

RECEIVED BY:
Umatilla County Surveyor
Date: _____
Rec'd By: _____
No. _____

Firm / Agency
Witness Tree Surveying
Address
P.O. Box G
Pilot Rock, Or. 97868
Party Chief
Stephen K, Haddock

REGISTERED
PROFESSIONAL
LAND SURVEYOR

Stephen K. Haddock

OREGON
JULY 9, 2001
STEPHEN K. HADDOCK
56295LS

RENEWS: 6-30-15

15-037-B