

Index File No. R-15


CORNER RECORD (SEARCH)

Tract or Survey No. 5-67 Cor. No. R-15

T 3S R. 31E R.D. Ukiah County Umatilla

Merid. Willamette N.F. Umatilla State Oregon

CORNER DIAGRAM

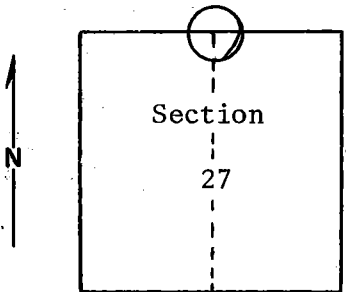

DESCRIBE CORNER MONUMENT FOUND

Material: Granite stone. Size: 12" x 10" x ?

Six ~~feet~~ inches above ground. No visible markings. Stone is 2 feet south of east-west fence.

2

DESCRIBE BEARING TREES OR OTHER OFFICIAL ACCESSORIES FOUND

48-inch rotting p.pine stump, 3 feet high, bears N8^{OW}, approximately 60 feet from stone. No scribing visible. (Possible B.T.)

No evidence of B.T. in SE quadrant.

3

DESCRIBE CORNER LOCATION RELATIVE TO NEAR-BY FEATURES, ALSO HOW TO REACH CORNER

PHOTO IDENTIFICATION DATA

Photo No. _____

Filed At. _____

Object Ident. _____

Ident. By _____

Signature _____

7

PLANE COORDINATE POSITION DATA

State _____ Zone _____

X _____

Y _____

Estab. By _____

Agency _____

8

Signature: B, Moore Title: Engineering Technician Division: _____ Headquarters: S, O, Date: November 1974 7100-52 REV. 65 5

4

CORNER RECORD (PERPETUATION)

MONUMENT: DESCRIBE NEW MONUMENT SET, OR WORK DONE TO PRESERVE EXISTING MONUMENT

9

ACCESSORIES : DESCRIBE NEW BT'S WITNESS OBJECTS ETC. ESTABLISHED, OR WORK DONE TO PRESERVE EXISTING EVIDENCE

10

Work Done By _____ Title _____ Date _____ State Registration No. or Agency _____

Certified Cor. Record Prepared ? Yes No Filed At: _____ Date _____

REMARKS

12

Index File No. T. R. M. Tract or Surv. No. Cor. 13