

USDA-FOREST SERVICE

Index File No. X-21

CORNER RECORD (SEARCH)

(Ref. FSM 7151.4)

Tract or Survey No. Sec 36 Cor. No. W 1/4

T 3S R. 31E

R.D. Ukiah County Umatilla

Merid. Willamette

N.F. Umatilla State Oregon

CORNER DIAGRAM

T3S R31E
1/4
S35 | S36



DESCRIBE CORNER MONUMENT FOUND

3" brass cap on 2 1/2" l. pipe protruding 12" out of ground in mound of stone.

DESCRIBE BEARING TREES OR OTHER OFFICIAL ACCESSORIES FOUND

A 22" dia P.St.Brs N61°W17.3 ft dist tagg S61°E17.31 ft dist (old BT) visible scribing.
A 12" dia R.Fir brs S52 1/2°W33.7 ft dist tagg N52 1/2°E51 lk dist-recent blaze.
A 14" dia Tam.brs S82°E 14.9 ft dist tagg N80°W23 1/2 lk dist-recent blaze.

PHOTO IDENTIFICATION DATA

Photo No. 616140 780-6
Filed At Umatilla Nat. Forest
Object Ident. Trees
Ident. By _____
Signature

PLANE COORDINATE POSITION DATA

State _____ Zone _____
X _____
Y _____
Estab. By _____
Agency

DESCRIBE CORNER LOCATION RELATIVE TO NEAR-BY FEATURES, ALSO HOW TO REACH CORNER

Yellow Jacket Road South to road #5420, then South on road #5420 approx. 3 miles to cattleguard, then West 300 ft along fence to fence corner near SW corner S36 then North 1/2 mile along fence to corner on South slope and light timber. 100 ft North of draw bottom.

Signature

William R. Wells

Title

PLS 1106

Division

Headquarters

Date

October 4, 1982

7100-52-(3/68)

CORNER RECORD (PERPETUATION)

MONUMENT: DESCRIBE NEW MONUMENT SET, OR WORK DONE TO PRESERVE EXISTING MONUMENT

Set steel fence post with 54-2 and 4 signs attached South of corner.
Cap is standard BLM. Cap marked:

T3S R31E
1/4
S35 | S36
1978

ACCESSORIES: DESCRIBE NEW BT'S WITNESS OBJECTS ETC. ESTABLISHED, OR WORK DONE TO PRESERVE EXISTING EVIDENCE

Blaze faces and 6" band around bearing trees are painted red. Trees tagged with 54-3 and 4 signs.

Work Done By W.R. Wells Title Surveyor Date 10/4/82 State Registration No. PLS 1106
or Agency

Certified Cor. Record Prepared? Yes No Filed At: Umatilla County Surveyor Office Date

REMARKS

Witnessed by: Leslie E. Wilson

Index File No.

X-21

T.

3S

R.

31E

M.

W.M.

Tract or Surv. No.

Sec 26

Cor.

W 1/4

Index
File No. X-21

CORNER RECORD (SEARCH)
(Ref. FSM 7151.4)

Tract or
Survey No. 5-69 Cor.
No. X-21


T. 3S R. 31E

R.D. Ukiah County Umatilla

Merid. Willamette

N.F. Umatilla State Oregon

CORNER DIAGRAM

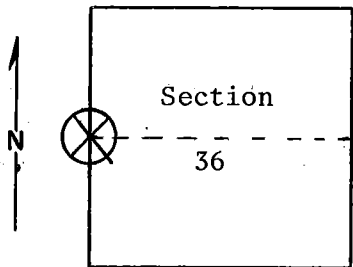

DESCRIBE CORNER MONUMENT FOUND

Material: None. Six inches of snow on ground.

DESCRIBE BEARING TREES OR OTHER OFFICIAL ACCESSORIES FOUND

20-inch p.pine stump, 3 feet high, with scribing on SE face, approximately 10 feet west of north-south fence line.

No evidence of other B.T.

PHOTO IDENTIFICATION DATA

Photo No. _____

Filed At. _____

Object Ident. _____

Ident. By _____

Signature

PLANE COORDINATE POSITION DATA

State _____ Zone _____

X _____

Y _____

Estab. By _____

Agency

Signature
B. Moore

Title
Engineering Technician

Division
Headquarters
S, O,

Date
November 1974

7100-52 (3/68)

CORNER RECORD (PERPETUATION)

MONUMENT: DESCRIBE NEW MONUMENT SET, OR WORK DONE TO PRESERVE EXISTING MONUMENT

ACCESSORIES : DESCRIBE NEW BT's WITNESS OBJECTS ETC. ESTABLISHED, OR WORK DONE TO PRESERVE EXISTING EVIDENCE

Work Done By _____ Title _____ Date _____ State Registration No. or Agency _____
Certified Cor. Record Prepared ? Yes No Filed At: _____ Date _____

REMARKS

Index File No. T. R. M. Tract or Surv. No. Cor. 12 13