

USDA-FOREST SERVICE

Index
File No. Z-13
T 3S R. 31E
Merid. Willamette

CORNER RECORD (SEARCH)

(Ref. FSM 7151.4)

R.D. Ukiah County Umatilla State Oregon
Tract or Survey No. Sec 34 Cor. No. SW Cor
N.F. Umatilla

CORNER DIAGRAM

T3S R31E
S33 | S34
T4S R31E
S2



DESCRIBE CORNER MONUMENT FOUND

3" brass cap on 2 1/2" l. pipe protruding 12" from ground in mound of stone.

DESCRIBE BEARING TREES OR OTHER OFFICIAL ACCESSORIES FOUND

- A 50" dia Pine Snag bears N9°E 121.5 ft dist (down).
- A 20" dia P. St. brs. N17 1/2° W 130.1 ft dist. tagg S17 1/2° E 130.1 ft dist (old BT visible scribing)
- A 14" P. Pine brs N65°W 135.0 ft dist tagg S65°E 204 lk dist-recent blaze.
- A 16" P. Pine brs N33 1/2° E 79.9 ft dist tagg S34°W 121 lk dist-recent blaze.

PHOTO IDENTIFICATION DATA

Photo No. 616140 380-3
Filed At. Umatilla Nat. Forest
Object Ident. Direct
Ident. By _____
Signature

PLANE COORDINATE POSITION DATA

State _____ Zone _____
X _____
Y _____
Estab. By _____
Agency

DESCRIBE CORNER LOCATION RELATIVE TO NEAR-BY FEATURES, ALSO HOW TO REACH CORNER

Road #5420 to road #5412-100, then West on road #5412-100 approx. 2.1 miles (just past N 1/4 S34) to road turning South through gate, then along road 1,000 ft to fork Left (South across draw), then approx. 0.7 mile South & West on road in thicket, 200 ft South of road to fence corner East & South and then 1,300 ft South along fence to corner. In open rolling South slope at crest of steep S slope and intersect of fences E, W and North.

Signature
William R. Well

Title _____ Division _____ Headquarters _____ Date _____

PLS 1106

October 21, 1982

7100-52-(3/68)

CORNER RECORD (PERPETUATION)

MONUMENT: DESCRIBE NEW MONUMENT SET, OR WORK DONE TO PRESERVE EXISTING MONUMENT

Set steel fence posts with 54-2 signs on both and 54-4 sign on one, North and East of corner.
Cap is standard. BLM.

Cap marked:

T3S R31E
S33 | S34
T4S R31E
S2
1978

ACCESSORIES: DESCRIBE NEW BT'S WITNESS OBJECTS ETC. ESTABLISHED, OR WORK DONE TO PRESERVE EXISTING EVIDENCE

Blaze faces and 6" bands around bearing trees are painted red. Trees tagged with 54-3 & 4 signs where needed.

Work Done By W.R. Wells Title Surveyor Date 10/21/82 State Registration No. PLS 1106
or Agency

Certified Cor. Record Prepared? Yes No Filed At: Umatilla County Surveyor Office Date

REMARKS

Witnessed by: Leslie E. Wilson

Index File No.
Z-13

T.

3S

R.

31E

M.

W.M.

Tract or Surv. No.

Sec 34

Cor.

SW Cor

Index File No. Z-13

CORNER RECORD (SEARCH)

Tract or Survey No. 5-46

Cor. No. Z-13


T 3S R. 31E

R.D. Ukiah County Umatilla

Merid. Willamette

N.F. Umatilla State Oregon

CORNER DIAGRAM

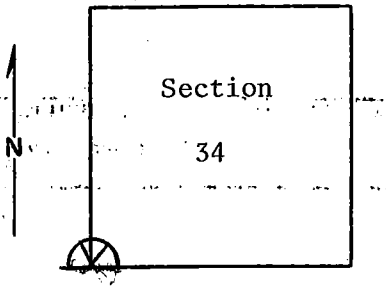

DESCRIBE CORNER MONUMENT FOUND

Material: Stone mound. Size: Mound ¹⁵ has 2-foot diameter, Ten inches above ground; good condition. No markings visible.

DESCRIBE BEARING TREES OR OTHER OFFICIAL ACCESSORIES FOUND

A 30-inch p.pine stump bears N18⁰W, approximately 198 links (GLO notes say 98 links). B.T. visible on sliver about 6 inches inside bark.

A large p.pine snag (badly burned) bears N10⁰E, approximately 180 links (GLO notes say 80 links). Has been burned (lightning struck) too badly to find scribing. (See Remarks.)

PHOTO IDENTIFICATION DATA

Photo No. _____
 Filed At. _____
 Object Ident. _____
 Ident. By _____
Signature

DESCRIBE CORNER LOCATION RELATIVE TO NEAR-BY FEATURES, ALSO HOW TO REACH CORNER

Stone mound sets about 5 feet NW from fence corner. Fences run east, west and north. See Carney Butte 7.5 minute quadrant map.

PLANE COORDINATE POSITION DATA

State _____ Zone _____
 X _____
 Y _____
 Estab. By _____
Agency

Signature
T. Hollamon

Title Division
Engineering Technician

Headquarters
S. O.

Date
November 7, 1974

7100-52
REV. 65 5

CORNER RECORD (PERPETUATION)

MONUMENT : DESCRIBE NEW MONUMENT SET, OR WORK DONE TO PRESERVE EXISTING MONUMENT

9

ACCESSORIES : DESCRIBE NEW BT's WITNESS OBJECTS ETC. ESTABLISHED, OR WORK DONE TO PRESERVE EXISTING EVIDENCE

I placed B.T. tag on B.T. stump in NW quadrant.

10

Work Done By _____ **Title** _____ **Date** _____ **State Registration No. or Agency** _____

Certified Cor. Record Prepared ? Yes No **Filed At:** _____ **Date** _____ 11

REMARKS

I assume the large burned snag to be the NE B.T. (over 50-inch diameter) because of its location in relation to the B.T. stump on which scribing is visible. The bearings to each from the rock mound approximately fits original GLO notes; however, the distances were called 80 links and 98 links respectively, but are actually approximately 180 links and 198 links. If the corner is assumed to be at the called distances, then the bearings would not fit as they now do. Also, the east-west fence would be approximately 65 feet on to private land, which is not the way it would likely be if the corner had been moved. 12

Index File No. T. R. M. **Tract or Surv. No.** **Cor,** 13