

Index

File No. A-25

CORNER RECORD (SEARCH)

(Ref. FSM 7151.4)

Tract or

Survey No. _____

Cor.

No. A-25


T 3S R. 32E

R.D. Ukiah County Umatilla

Merid. Willamette

N.F. Umatilla State Oregon

CORNER DIAGRAM

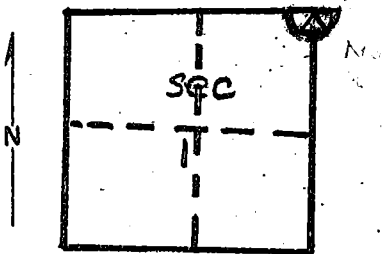

DESCRIBE CORNER MONUMENT FOUND

Material: stone, Size: 14"x10"x5"
 Height above ground: All. Condition: good.
 Markings: six notches on two sides

2

DESCRIBE BEARING TREES OR OTHER OFFICIAL ACCESSORIES FOUND

No accessories were found.
 The stone was all we found and it was on top of ground.
 Bearing trees were gone. Put stone in approximate location.

3

PHOTO IDENTIFICATION DATA

Photo No. _____

Filed At. _____

Object Ident. _____

Ident. By _____

Signature

7

DESCRIBE CORNER LOGATION RELATIVE TO NEAR-BY FEATURES, ALSO HOW TO REACH CORNER

PLANE COORDINATE POSITION DATA

State _____ Zone _____

X _____

Y _____

Estab. By _____

Agency

8

Signature

m.l.c.

Title

For. Tech.

Division

USFS

Headquarters

Ukiah

Date

10/5/72

7100-52-(3/68)

4

5

USDA-FOREST SERVICE


Index
File No. A-1
T 3S R. 33E
Merid. WILLAMETTE

CORNER RECORD (SEARCH)
(Ref. FSM 7151.4)

Tract or
Survey No. _____ Cor.
No. _____

R.D. NORTH FORK J.D. County UMATILLA
N.F. UMATILLA State OREGON

CORNER DIAGRAM

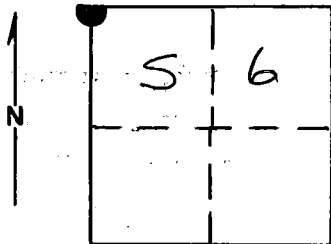

DESCRIBE CORNER MONUMENT FOUND

Found a stone 16x12x6 inches marked with 6 notches on 2 sides and 5 notches on another side of the stone. Laying in a small mound of stone.

DESCRIBE BEARING TREES OR OTHER OFFICIAL ACCESSORIES FOUND

Found a 18 inch diameter Douglas Fir S53°E, 38 lks, opened on at least 2 previous occasions, destroying any scribing if this was the original BT. Cannot positively identify this as the original BT.

PHOTO IDENTIFICATION DATA

Photo No. 1687-43
Filed At. Ranger Office
Object Ident. As shown
Ident. By D.I. Griffith
Signature

DESCRIBE CORNER LOCATION RELATIVE TO NEAR-BY FEATURES, ALSO HOW TO REACH CORNER

Corner falls on timbered Northwest slope, approximately 175 feet South of an East-West fenceline and approximately 400 feet West of a road at the gate.

PLANE COORDINATE POSITION DATA

State _____ Zone _____
X _____
Y _____
Estab. By _____

Signature _____
Agency

Title SURVEYOR Division _____ Headquarters _____ Date 9-7-88 FS-7100-52 (3/68)

CORNER RECORD (PERPETUATION)

MONUMENT: DESCRIBE NEW MONUMENT SET, OR WORK DONE TO PRESERVE EXISTING MONUMENT

Set a 2½"x30" aluminum pipe with aluminum cap marked as shown:
Pipe is set 28 inches in the ground.

T2S R32E	
S 35	
S 1	S 6
R32E	R33E
T3S	
CC	
1988	
OPLS 644	

Raised a small mound of stone around monument.
Marked the original corner stone "AM" and
buried it East and alongside of monument.

ACCESSORIES : DESCRIBE NEW BT'S WITNESS OBJECTS ETC. ESTABLISHED, OR WORK DONE TO PRESERVE EXISTING EVIDENCE

New BTs:

A 13 inch diameter Lodgepole Pine bears S27°E, 29.91 feet marked T3S R33E S6 CC BT
A 11 inch diameter Douglas Fir bears S78°W, 22.54 feet marked T3S R32E S1 CC BT

Painted a 6 inch red band around all bearing trees and attached 54-3 and 54-9 signs.

Set a steel fencepost 2.90 feet East with 54-9 and 54-2 signs attached.

Work Done By D.I. Griffith Title Surveyor Date 9-1-88 State Registration No. OPLS 644
or Agency

Certified Cor. Record Prepared ? Yes No Filed At: Umatilla County Surveyor Office Date 10-88

REMARKS

Witnesses: Rick Robinson and Jeff Petersen

Index File No. A-1 T. 35 R. 33E WM. Tract or Surv. No. Cor.