

CERTIFIED RECORD OF LAND CORNER MONUMENTATION

J - 13
DIAGRAM

History of original corner establishment:

The original corner was established by George S. Pershin on May 24, 1882, under GLO contract No. 430, as follows:

Set a basalt stone 12" x 8" x 7" on northwest slope, 8" in ground for corner to sections 9, 10, 15 & 16, marked with 4 notches on south and 3 notches on east edges, from which:

- A 24" pine bears N14°E, 32 links (21.12 feet).
- A 16" tamarack bears S44°E, 72 links (47.52 feet).
- A 18" tamarack bears S17°W, 73 links (48.18 feet).
- A 20" fir bears N88°W, 55 links (36.3 feet).

T3S R32E
S9 | S10
S16 | S15
PLS 1636
1999

Original corner evidence recovered:

Found the original corner stone solidly set, but up-side-down, having rolled down hill about 18". The corner stone is 13" x 10" x 8" and is plainly marked with four notches on one (south) edge and 3 notches on another (east) edge. From the point 19" up hill of the stone:


- A sawn, burnt and decayed Ponderosa Pine stump, with scribes "BT" visible, bears N14°E, 21.1 feet.
 - A sawn and shattered Western Larch stump, no marks remain, bears S44°E, 46.0 feet. 47.5 feet slope distance.
 - A sawn and decayed Western Larch stump with healed blaze and scribe, "6", visible inside, bears S17°W, 45.8 feet. 48.2 feet slope distance.
- The original fir bearing tree to the northwest is gone.

Monument and accessories established to perpetuate the original location of this corner.

At the corner point as determined by reference to the original bearing trees, I set a 1" x 30" iron pipe 22" into the ground. A 2 1/2" brass cap attached is marked as shown in the diagram above. I bury the corner stone to the east of the pipe and build a mound of stones around the monument, from which:

- A 13" Douglas-fir, scribed "T3S R32E S10 BT", bears N24°E, 17.9 feet.
 - A 11" Douglas-fir, scribed "T3S R32E S15 BT", bears S4°E, 22.2 feet.
 - A 6" Western Larch, scribed "T3S R32E S16 BT", bears S53°30'W, 39.1 feet.
 - A 6" White Fir, scribed "T3S R32E S9 BT", bears N87°W, 38.6 feet.
- The four new bearing trees are scribed on double blazes, have a 3/4" brass washer, marked "PLS 1636", nailed flush to the scribed "E", and have a "Bearing Object" sign nailed above the blazes. The original bearing tree stumps have a "Bearing Tree" sign nailed to them.

I hereby certify the above corner point was perpetuated as hereon described on October 21, 1999. Magnetic declination: 18°E.

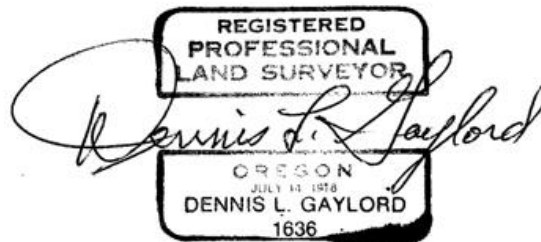

Renews June 30, 2001

Recorded at the office of County Surveyor, County of Umatilla, State of Oregon, on October 24, 1999.

RECEIVED BY

Umatilla County Surveyor

Date 10-99

Rec'd By KK

No. 99-264R