

USDA-FOREST SERVICE

Index

File No. V-5

T 3S R. 32E

Merid. Willamette

CORNER RECORD (SEARCH)

(Ref. FSM 7151.4)

R.D. Ukiah County Umatilla Tract or Survey No. Sec 29 Cor. No. SW CC

N.F. Umatilla State Oregon

CORNER DIAGRAM

R31E T3S R32E

S25 | S29 CC
| S32 AM



DESCRIBE CORNER MONUMENT FOUND

None.

DESCRIBE BEARING TREES OR OTHER OFFICIAL ACCESSORIES FOUND

A 12" dia Fir Stump bears N76°E 52.14 ft dist tagged S76°E 52 ft (old BT, Visible scribing).

PHOTO IDENTIFICATION DATA

Photo No. _____

Filed At. _____

Object Ident. _____

Ident. By _____

Signature

PLANE COORDINATE POSITION DATA

State _____ Zone _____

X _____

Y _____

Estab. By _____

Agency

Signature

Willie R. Wells

Title

PLS 1106

Division

Headquarters

Date

September 29, 1982

7100-52-(3/68)

CORNER RECORD (PERPETUATION)

MONUMENT: DESCRIBE NEW MONUMENT SET, OR WORK DONE TO PRESERVE EXISTING MONUMENT

Set 2 1/2" brass cap on 2 1/2" x 30" l. pipe 22" in ground with mound of stone.

Set steel fence post with 54-4 sign, 3.7 ft East of corner, Cap marked:

T3S
S25 S29 CC
S32 AM
R31E R32E
1982
PLS 1106

ACCESSORIES: DESCRIBE NEW BT'S WITNESS OBJECTS ETC. ESTABLISHED, OR WORK DONE TO PRESERVE EXISTING EVIDENCE

A 10" dia Gr. Fir bears S50°E 6.8 ft dist marked: T3S R32E S32 CC BT.

A 10" dia Grnd. Fir bears N15 1/2°E 37.5 ft dist marked: T3S R32E S29 CC BT.

Blaze faces and 6" band around bearing trees painted red. Tagged trees with 54-3 and 4 signs
Each new BT has lower blaze, scribed BT, with brass washer stamped PLS 1106 nailed flush.

10

Work Done By W.R. Wells Title Surveyor Date 9/29/82 State Registration No. PLS 1106
or Agency

Certified Cor. Record Prepared? Yes No Filed At: Umatilla County Surveyor Office Date

11

REMARKS

Witnessed by: Leslie E. Wilson

12

Index File No. V-5 T. 3S R. 32E M. W.M. Tract or Surv. No. Sec 29 Cor. SW CC

13

USDA-FOREST SERVICE

Index

File No. V-5

CORNER RECORD (SEARCH)

(Ref. FSM 7151.4)

Tract or

Survey No. _____

Cor.

No. _____

T 35 R. 32E

R.D. UKIAH


County UMATILLA

Merid. WILL

N.F. UMATILLA

State OREGON

CORNER DIAGRAM

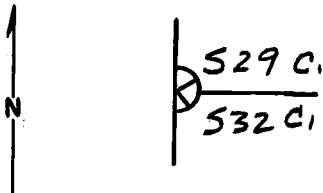

DESCRIBE CORNER MONUMENT FOUND

NONE

DESCRIBE BEARING TREES OR OTHER OFFICIAL ACCESSORIES FOUND

ORIGINAL 8" FIR, NOW A 12" BROKEN FIR STUMP WITH SCRIBING VISIBLE BEARS N76°E, 52 1/2 ft.

THE PINE B.T. IS GONE.

PHOTO IDENTIFICATION DATA

Photo No. _____

Filed At. _____

Object Ident. _____

Ident. By _____

Signature

PLANE COORDINATE POSITION DATA

State _____ Zone _____

X _____

Y _____

Estab. By _____

Agency

DESCRIBE CORNER LOCATION RELATIVE TO NEAR-BY FEATURES, ALSO HOW TO REACH CORNER

CORNER IS IN A N-S FENCE, 865 FT NORTH OF

25/
36/

Signature Dennis L. Hayford

Title

Division PLS 1636

Headquarters

Date 3-10-81

7100-52-(3.68)

CORNER RECORD (PERPETUATION)

MONUMENT : DESCRIBE NEW MONUMENT SET, OR WORK DONE TO PRESERVE EXISTING MONUMENT

9

ACCESSORIES : DESCRIBE NEW BT'S WITNESS OBJECTS ETC. ESTABLISHED, OR WORK DONE TO PRESERVE EXISTING EVIDENCE

10

Work Done By _____ Title _____ Date _____ State Registration No.
or Agency _____

Certified Cor. Record Prepared ? Yes No Filed At: _____ Date _____ 11

REMARKS

12

Index File No. T. R. M. Tract or Surv. No. Cor. 13