

USDA-FOREST SERVICE

Index
File No. E-25

T 3S R. 32E

Merid. W.M.

CORNER RECORD (SEARCH)

(Ref. FSM 7151.4)

R.D. Ukiah

County

Umatilla

N.F. Umatilla

State

Or.

Tract or
Survey No.

Cor.
No.

CORNER DIAGRAM



R32E R33E
S1 | S6
S12 | S7

DESCRIBE CORNER MONUMENT FOUND

2 1/2" I.P. with B.C. mkd:

Cor. in stone mound.

T3S
R32E R33E
S1 | S6
S12 | S7
1977

DESCRIBE BEARING TREES OR OTHER OFFICIAL ACCESSORIES FOUND

P. pine, 15", N27°E, 86.9 ft.
P. pine, 23", S78°E, 46.2 ft.
D. fir, 13", S67°W, 50.7 ft.
D. fir, 16", N66°W, 63.7 ft.

PHOTO IDENTIFICATION DATA

Photo No. 680-289

Filed At. S.O.

Object Ident. trees

Ident. By F. S. Munro
FR Munro

PLANE COORDINATE POSITION DATA

State _____ Zone _____

X _____

Y _____

Estab. By _____

Agency

DESCRIBE CORNER LOCATION RELATIVE TO NEAR-BY FEATURES, ALSO HOW TO REACH CORNER

Cor. falls in open area on NW slope. E-W fence is 17' S. From K tag on 085 rd. go 975' E. along posted property line.

Signature

F. S. Munro

Title

L.S.

Division

Headquarters

Date

9/26/84

7100-52 (3-68)

CORNER RECORD (PERPETUATION)

MONUMENT: DESCRIBE NEW MONUMENT SET, OR WORK DONE TO PRESERVE EXISTING MONUMENT

None.

ACCESSORIES : DESCRIBE NEW BT'S WITNESS OBJECTS ETC. ESTABLISHED, OR WORK DONE TO PRESERVE EXISTING EVIDENCE

BTs have reqd. paint, tags & signs.

Work Done By F.S. Munro Title L.S. Date 9/1/84 State Registration No. 1832
or Agency

Certified Cor. Record Prepared ? Yes No Filed At: _____ Date _____

REMARKS

Index File No. E-25 T. R. M. Tract or Surv. No. Cor.

3S 32E W.M.

Index File No. E-1


CORNER RECORD (SEARCH)
(Ref. FSM 7151.4)

Tract or Survey No. _____ Cor. No. E-1

T 35 R. 33E R.D. _____ County _____

Merid. _____ N.F. _____ State _____

CORNER DIAGRAM

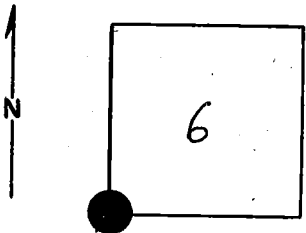

DESCRIBE CORNER MONUMENT FOUND

~~CR T35 R32E E-25~~
Brass Cap: 1977 s^{ca} mon. file

DESCRIBE BEARING TREES OR OTHER OFFICIAL ACCESSORIES FOUND

PHOTO IDENTIFICATION DATA

Photo No. _____
Filed At. _____
Object Ident. _____
Ident. By _____

Signature

PLANE COORDINATE POSITION DATA

State _____ Zone _____
X _____
Y _____
Estab. By _____

Agency

Signature

Title

Division

Headquarters

Date

7100-52-(3/68)

6

7

8

1

2

3

4

5

CORNER RECORD (PERPETUATION)

MONUMENT: DESCRIBE NEW MONUMENT SET, OR WORK DONE TO PRESERVE EXISTING MONUMENT

9

ACCESSORIES : DESCRIBE NEW BT'S, WITNESS OBJECTS ETC. ESTABLISHED, OR WORK DONE TO PRESERVE EXISTING EVIDENCE

10

Work Done By _____ Title _____ Date _____ State Registration No. or Agency _____

Certified Cor. Record Prepared ? Yes No Filed At: _____ Date _____

11

REMARKS

12

Index File No. T. R. M. Tract or Surv. No. Cor. _____

13