

Index File No. _____

N-17

CORNER RECORD (SEARCH)

Tract or Survey No. _____


Cor. No. N-17

45 14

T 3S R. 33E R.D. Ukiah County Umatilla

Merid. Willamette N.F. Umatilla State Oregon

CORNER DIAGRAM

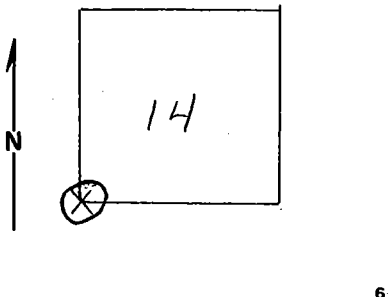

DESCRIBE CORNER-MONUMENT FOUND *Original notes*

DESCRIBE BEARING TREES OR OTHER OFFICIAL ACCESSORIES FOUND ²

Corner consists of a rock in good condition 3" above ground
DF 26" N32W 28' (S15)
YP 30" S38W 24' (22)
DF 26" S17E 28' (not legible)

PHOTO IDENTIFICATION DATA ⁶

Photo No. _____

Filed At. _____

Object Ident. _____

Ident. By _____

Signature ⁷

PLANE COORDINATE POSITION DATA ⁷

State _____ Zone _____

X _____

Y _____

Estab. By _____

Agency ⁸

DESCRIBE CORNER LOCATION RELATIVE TO NEAR-BY FEATURES, ALSO HOW TO REACH CORNER

Meadow Creek, proceed N. up ridge on E. side of canyon, about $\frac{1}{4}$ mi. distance.

Signature

Title

Division

Headquarters

Date

7100-52 ⁴

151 BERNARD

J.R.E.

8-17-32

REV. 65 5

CORNER RECORD (PERPETUATION)

MONUMENT: DESCRIBE NEW MONUMENT SET, OR WORK DONE TO PRESERVE EXISTING MONUMENT

ACCESSORIES DESCRIBE NEW BT'S WITNESS OBJECTS ETC. ESTABLISHED, OR WORK DONE TO PRESERVE EXISTING EVIDENCE

Work Done By _____ Title _____ Date _____ State Registration No. or Agency _____
Certified Cor. Record Prepared ? Yes No Filed At: _____ Date _____

REMARKS

Index File No. *N-17T* R. M. Tract or Surv. No. Cor. _____