

Index

File No. A-7T 4S R. 33EMerid. Willamette

(PA)

CORNER RECORD (SEARCH)

(Ref. FSM 7151.4)


Tract or

Survey No. _____

Cor.

No. A-7R.D. Ukiah County UmatillaN.F. Umatilla State Oregon

CORNER DIAGRAM

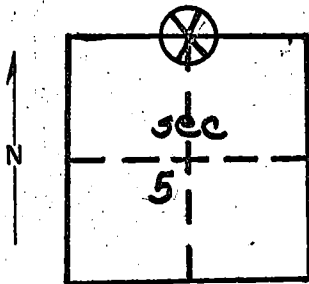

DESCRIBE CORNER MONUMENT FOUND

None was found.

PHOTO IDENTIFICATION DATA

Photo No. _____

Filed At. _____

Object Ident. _____

Ident. By _____

Signature _____

PLANE COORDINATE POSITION DATA

State _____ Zone _____

X _____

Y _____

Estab. By _____

Agency _____

DESCRIBE BEARING TREES OR OTHER OFFICIAL ACCESSORIES FOUND

Found one section poster on the ground approximately where corner is. Found remains of one bearing tree with the letters BT on it approximately 20' to the SE of the poster.

DESCRIBE CORNER LOCATION RELATIVE TO NEAR-BY FEATURES, ALSO HOW TO REACH CORNER

Starting at located section corner T4S R33E sections 5, 6, 31, and 32 we chained east to $\frac{1}{4}$ corner. It is about 640' east of old Bear Wallow road. Corner needs to be reestablished and new bearing tree.

Signature

MLC & CTB

Title

GS-5

Division

USFS

Headquarters

UKIAH

Date

5/25/70

7100-52-(3/68)

5