

Index
File No. Z-21

CORNER RECORD (SEARCH)
(Ref. FSM 7151.4)

Tract or
Survey No. _____ Cor. No. Sec


T 2S & 3SR 34E

R.D. La Grande County Union

Merid. Willamette

N.F. Wallowa-Whitman State Oregon

CORNER DIAGRAM

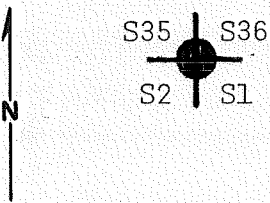

DESCRIBE CORNER MONUMENT FOUND

Found 1917 monument of record. Stamped;

T2S R34E
S35 S36
S2 S1
R3S R34E
1917

DESCRIBE BEARING TREES OR OTHER OFFICIAL ACCESSORIES FOUND

From which by magnetic declination of N20°E;
A 30" pine bears N48°E, 25.7 ft. with visible scribing.
A 24" pine bears S77°E, 26.4 ft. with visible scribing.
An 18" pine stump bears S79°W, 17. ft., with visible BT.
A 30" dead pine bears N79°W, 126.8 ft. with visible scribing.

PHOTO IDENTIFICATION DATA

Photo No. FWD-17-232
Filed At. La Grande
Object Ident. Direct
Ident. By B. Barbour RLS
Signature

DESCRIBE CORNER LOCATION RELATIVE TO NEAR-BY FEATURES, ALSO HOW TO REACH CORNER

PLANE COORDINATE POSITION DATA

State _____ Zone _____
X _____
Y _____
Estab. By _____
Agency

Barry B. Barbour
Signature

Title S. Division _____ Headquarters Sumpter Date 11-11-80 7100-52-(3/68)

CORNER RECORD (PERPETUATION)

MONUMENT: DESCRIBE NEW MONUMENT SET, OR WORK DONE TO PRESERVE EXISTING MONUMENT

Built mound of stone around to cap.

ACCESSORIES : DESCRIBE NEW BT'S WITNESS OBJECTS ETC. ESTABLISHED, OR WORK DONE TO PRESERVE EXISTING EVIDENCE

From which by magnetic declination of N20°E, I add
A 16" pine bears S70°W, 61.1 ft. scribed T3S R34E S2 BT. A 9" pine bears
N64°W, 50.3 ft. scribed T2S R34E S35 BT. Painted blazes red and 6" red band
around. Placed 54-3s, 54-4s, and brass washers stamped PLS 1051 on the BTs.
Placed 54-2 and 54-4 on a steel fence post 5' east and 54-2 on a steel fence
post 5' north of the corner.

Work Done By B. B. Barbour Title P. L. S. Date 11-11-80 State Registration No. OR 1051
or Agency

Certified Cor. Record Prepared ? Yes No Filed At: Union County Surveyor's Date

REMARKS

Witnesses: Daniel Rowland
Douglas Moser
Ronald Gilroy

Index
File No. 221

CORNER RECORD (SEARCH)

(Ref. FSM 7151.4)

Tract or Survey No. _____ Cor. No. _____

T 25 R. 34 E


R.D. LaGrande County Union

Merid. Will

N.F. W-W State Oregon

CORNER DIAGRAM

R 34 E

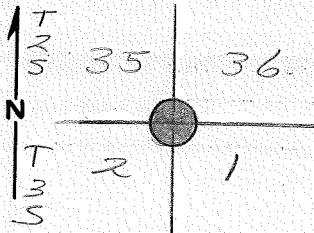

DESCRIBE CORNER MONUMENT FOUND

Brass Cap set in 1917

DESCRIBE BEARING TREES OR OTHER OFFICIAL ACCESSORIES FOUND

Sec. 1 - 26" P.P. Live, Scribe visible
Sec. 2 - 20" stump, Scribe Visible
Sec. 35 - 30" PP Dead standing, Scribe visible
Sec. 36 - 26" P.P. Live, Scribe visible

PHOTO IDENTIFICATION DATA

Photo No. _____
Filed At. _____
Object Ident. _____
Ident. By _____
Signature

DESCRIBE CORNER LOCATION RELATIVE TO NEAR-BY FEATURES, ALSO HOW TO REACH CORNER

PLANE COORDINATE POSITION DATA

State _____ Zone _____
X _____
Y _____
Estab. By _____
Agency

Signature Dave Dahlstrom Title CET Division _____ Headquarters LaGrande Date 2-6-80

CORNER RECORD (PERPETUATION)

MONUMENT : DESCRIBE NEW MONUMENT SET, OR WORK DONE TO PRESERVE EXISTING MONUMENT

9

ACCESSORIES : DESCRIBE NEW BT'S WITNESS OBJECTS ETC. ESTABLISHED, OR WORK DONE TO PRESERVE EXISTING EVIDENCE

10

Work Done By _____ **Title** _____ **Date** _____ **State Registration No. or Agency** _____

Certified Cor. Record Prepared ? Yes No **Filed At:** _____ **Date** _____

11

REMARKS

12

Index File No. _____ **T.** _____ **R.** _____ **M.** _____ **Tract or Surv. No.** _____ **Cor.** _____

13