


**CERTIFIED RECORD OF LAND CORNER MONUMENTATION / RESTORATION**

T.4N., R.27E., INDEX A-17

**History of original corner establishment:**

This corner was originally established by Nicholas Waldon under G.L.O. contract No. 209, dated July 6, 1874. Survey General notes state:

*Drove charred stake and raised mound of earth with pits as Per instructions for closing cor. to Secs. 2 & 3.*

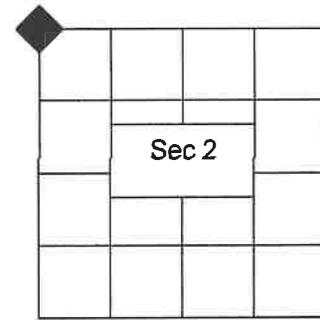

**Description of corner evidence found:**

No evidence of this corner is found.

**Description of monument and accessories I establish to perpetuate the original location of this corner:**

At the proportionate position determined on Umatilla County Map of Survey #16-018-C, done by me and filed on January 27, 2016 in the Umatilla County Survey records, I set a 2-3/8" x 30" aluminum pipe monument w/3" dia. cap stamped as shown in the DIAGRAM, 22" in the ground, from which:

- A 5/8" dia. x 30" rebar pin bears North, 50.00 ft.
- A 5/8" dia. x 30" rebar pin bears N89°20'56"E, 50.00 ft.
- A 5/8" dia. x 30" rebar pin bears S00°24'01"E, 44.00 ft. (1 ft. north of the old E-W Umatilla Weapons Depot security fence)
- A 5/8" dia. x 30" rebar pin bears S89°20'56"W, 50.00 ft.

All rebar pins are capped with a yellow plastic cap marked "Survey Marker PLS 49865". Set 5' t-post with a Land Survey Monument sign 2' North of monument.

**DIAGRAM**

T5N R27E  
S34  
-----  
S3 | S2  
C C  
T4N R27E  
2025  
PLS 49865

Measurements to accessories taken with:  
Trimble R6 Base & R8 rover. Basis of Bearings are said Survey #16-018-C

Observed raw rtk: Lat N 45°51'53.56213"  
Long W 119°24'49.62891"

I hereby certify that the above corner point was perpetuated as shown hereon on July 30, 2025

Witness:

Office of County Surveyor County of UMATILLA  
State of Oregon. I hereby certify that the within instrument was filed in this office for record on the \_\_\_\_\_ day of \_\_\_\_\_, 2025

\_\_\_\_\_ by \_\_\_\_\_  
County Surveyor Deputy

REGISTERED  
PROFESSIONAL  
LAND SURVEYOR

OREGON  
JULY 13; 1999  
KENNETH H. DELANO JR.  
49865

RENEWS: 1/1/2026