


CERTIFIED RECORD OF LAND CORNER MONUMENTATION / RESTORATION

T.4N., R.27E., INDEX E-17

History of original corner establishment:

This corner was originally established by Nicholas Waldon under G.L.O. contract No. 209, dated July 6, 1874. Survey General notes state:

Drove charred stake and raised mound of earth with pits as Per instructions for Cor. to Secs. 2, 3, 10 & 11.

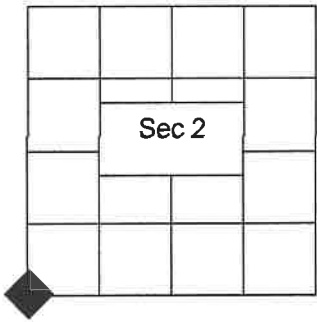

Description of corner evidence found:


No evidence of this corner is found.

Description of monument and accessories I establish to perpetuate the original location of this corner:

At the proportionate position determined on Umatilla County Map of Survey #16-018-C, done by me and filed on January 27, 2016 in the Umatilla County Survey records, I set a 2-3/8" x 30" aluminum pipe monument w/3" dia. cap stamped as shown in the DIAGRAM, 24" in the ground, from which:

- A 5/8" dia. x 30" rebar pin bears N00°24'01"W, 60.00 ft.
- A 5/8" dia. x 30" rebar pin bears N88°55'42"E, 20.44 ft.
- A 5/8" dia. x 30" rebar pin bears S00°32'43"E, 41.14 ft.
- A 5/8" dia. x 30" rebar pin bears S89°01'39"W, 50.00 ft.

All rebar pins are capped with a yellow plastic cap marked "Survey Marker PLS 49865". Set 5' t-post with a Land Survey Monument sign 2' North of monument.

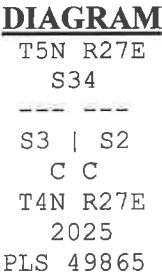

Measurements to accessories taken with:
Trimble R6 Base & R8 rover. Basis of Bearings are said Survey #16-018-C

Observed raw rtk: Lat N 45°51'00.25042"
Long W 119°24'50.12263"

I hereby certify that the above corner point was perpetuated as shown hereon on August 5, 2025

Witness:

Office of County Surveyor County of UMATILLA
State of Oregon. I hereby certify that the within instrument was filed in this office
for record on the _____ day of _____, 2025

_____ by _____
County Surveyor Deputy

REGISTERED
PROFESSIONAL
LAND SURVEYOR

OREGON
JULY 13, 1999
KENNETH H. DELANO JR.
49865
RENEWS: 1/1/2026