


CERTIFIED RECORD OF LAND CORNER MONUMENTATION / RESTORATION

T.4N., R.27E., INDEX E-21

History of original corner establishment:

This corner was originally established by Nicholas Waldon under G.L.O. contract No. 209, dated July 6, 1874. Survey General notes state:

Drove charred stake and raised mound of earth with pits as Per instructions for Cor. to Secs. 1, 2, 11 & 12.

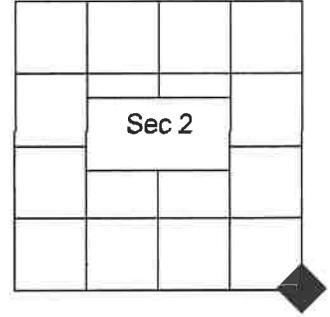

Description of corner evidence found:

No evidence of this corner is found.

Description of monument and accessories I establish to perpetuate the original location of this corner:

At the proportionate position determined on Umatilla County Map of Survey #16-018-C, done by me and filed on January 27, 2016 in the Umatilla County Survey records, I set a 2-3/8" x 30" aluminum pipe monument w/3" dia. cap stamped as shown in the DIAGRAM, 26" in the ground, from which:

- A 5/8" dia. x 30" rebar pin bears N00°15'46"W, 50.00 ft.
- A 5/8" dia. x 30" rebar pin bears N89°35'51"E, 50.00 ft.
- A 5/8" dia. x 30" rebar pin bears S00°42'10"E, 50.00 ft.
- A 5/8" dia. x 30" rebar pin bears S88°55'42"W, 50.00 ft.

All rebar pins are capped with a yellow plastic cap marked "Survey Marker PLS 49865". Set 5' t-post with a Land Survey Monument sign 2' North of monument.

DIAGRAM

T4N R27E
S2 | S1
--- ---
S11 | S12

2025
PLS 49865

Measurements to accessories taken with:
Trimble R6 Base & R8 rover. Basis of Bearings are said Survey #16-018-C

Observed raw rtk: Lat N 45°51'00.51964"
Long W 119°23'35.49507"

I hereby certify that the above corner point was perpetuated as shown hereon on August 5, 2025

Witness:

Office of County Surveyor County of UMATILLA
State of Oregon. I hereby certify that the within instrument was filed in this office for record on the _____ day of _____, 2025

_____ by _____
County Surveyor Deputy

REGISTERED
PROFESSIONAL
LAND SURVEYOR

OREGON
JULY 13, 1999
KENNETH H. DELANO JR.
49865
RENEWS: 1/1/2026

26-012-C