


**CERTIFIED RECORD OF LAND CORNER MONUMENTATION / RESTORATION**

T.4N., R.27E., INDEX J-13

**History of original corner establishment:**

This corner was originally established by Nicholas Walden under G.L.O. contract No. 209, dated July 6, 1874. Survey General notes state:

*Drove charred stake and raised mound of earth with pits as Per instructions for Cor to Secs 9, 10, 15 & 16. Drove Willow stake 2 ft long 2 in square in SE pit.*

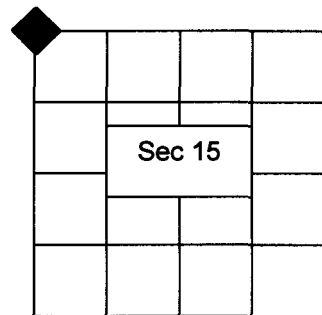

**Description of corner evidence found:**

No evidence of this corner is found. Set monument at double proportionate measure.

**Description of monument and accessories I establish to perpetuate the original location of this corner:**

At proportionate position determined by survey, Set a 2-1/2" x 30" aluminum pipe monument with 3" dia. cap stamped as shown in the DIAGRAM, flush with the paved surfaced, from which:

- A 5/8" rebar pin bears N57°29'56"W, 24.97 ft.
- A 5/8" rebar pin with 1 groove filed on the top, bears N44°49'20"E, 21.12 ft.
- A 5/8" rebar pin with 2 grooves filed on the top, bears S46°24'43"E, 23.43 ft.
- A 5/8" rebar pin with 3 grooves filed on the top, bears S48°54'39"W, 32.51 ft.

Placed an orange plastic cap marked "FS&E Survey Marker" on all rebar pins. Set a green steel "T" post with white top 3 ft. East of monument.

Measurements to accessories taken with: Topcon Hyper II GPS (RTK)

I hereby certify that the above corner point was perpetuated as shown hereon on July 30, 2015

Witness: D. Mitchell Ferguson, LSIT  
David Herburger


Office of County Surveyor \_\_\_\_\_ County of Umatilla  
State of Oregon. I hereby certify that the within instrument was filed in this office  
for record on the 27th day of January, 2016

\_\_\_\_\_ by Doug Tolat  
County Surveyor Deputy

Refer to Map of Survey # 16-018-C

**DIAGRAM**

T4N R27E  
S9 | S10  
-----  
S16 | S15  
2015  
PLS 49865

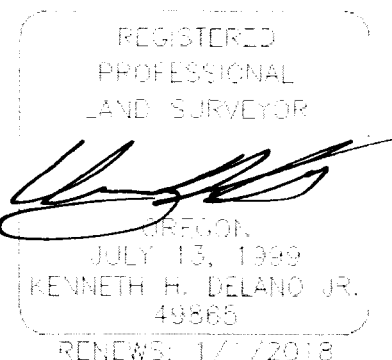

16-018-C