


CERTIFIED RECORD OF LAND CORNER MONUMENTATION / RESTORATION

T.4N., R.27E., INDEX R-21

**History of original corner establishment:**

This corner was originally established by Nicholas Waldon under G.L.O. contract No. 209, dated July 6, 1874. Survey General notes state:

*Drove charred stake and raised mound of earth with pits as Per instructions for Cor. to Secs. 23, 24, 25 & 26.*

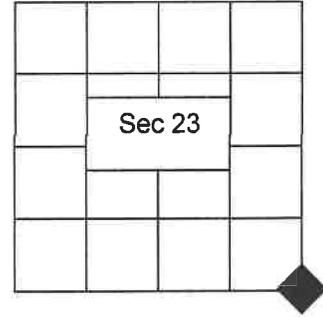

**Description of corner evidence found:**

No evidence of this corner is found.

**Description of monument and accessories I establish to perpetuate the original location of this corner:**

At the proportionate position determined on Umatilla County Map of Survey #16-018-C, done by me and filed on January 27, 2016 in the Umatilla County Survey records, I set a 2-3/8" x 30" aluminum pipe monument w/3" dia. cap stamped as shown in the DIAGRAM, 26" in the ground, from which:

- A 5/8" dia. x 30" rebar pin bears N00°47'57"W, 50.00 ft.
- A 5/8" dia. x 30" rebar pin bears N89°17'21"E, 50.00 ft.
- A 5/8" dia. x 30" rebar pin bears S00°37'56"E, 50.00 ft.
- A 5/8" dia. x 30" rebar pin bears S89°13'38"W, 50.00 ft.

All new rebar pins are capped with a yellow plastic cap marked "Survey Marker PLS 49865". Set 5' t-post with a Land Survey Monument sign 2' North of Corner.

**DIAGRAM**

T4N R27E  
S23 | S24  
---  
S26 | S25

2025  
PLS 49865

Measurements to accessories taken with:

Trimble R6 Base & R8 rover. Basis of Bearings are said Survey #16-018-C

Observed raw rtk: Lat N 45°48'23.6259"  
Long W 119°23'35.63254"

I hereby certify that the above corner point was perpetuated as shown hereon on August 11, 2025

Witness:

Office of County Surveyor County of UMATILLA  
State of Oregon. I hereby certify that the within instrument was filed in this office for record on the \_\_\_\_\_ day of \_\_\_\_\_, 2025

\_\_\_\_\_ by \_\_\_\_\_  
County Surveyor Deputy

REGISTERED  
PROFESSIONAL  
LAND SURVEYOR

OREGON  
JULY 13, 1999  
KENNETH H. DELANO JR.  
49865

RENEWS: 1/1/2026