

OREGON CORNER RESTORATION FORM

Section 3 Township 4N Range 28E

A-15

County Umatilla Date 5/18/95

CORNER DESIGNATION

N 1/4 Section 3

(Closing 1/4 Corner)



Previous Renewals/Surveys, etc. Ebenezer E. Haft set post in mound with trench and pits in 1860; Harris found 1 1/2" iron pipe in 1976; Krumbein set 2 1/2" brass cap in 1980.

Monument(s) & Accessories Found: (Condition and Source)

Found 2 1/2" brass cap buried approximately 8" below gravel road surface. Found 3 aluminum tags stamped LS 951 (no restoration record). No other accessories found.

- Condition Report Only
- Not Found
- Renewed
- Unrecorded
- Surveyed In
- Referenced Out

Monument Detail

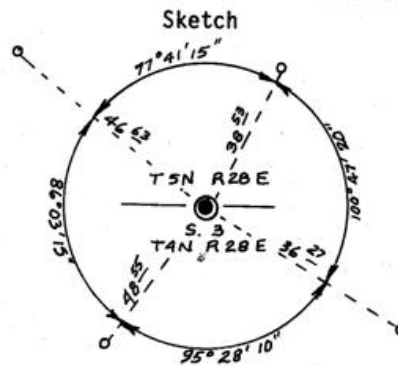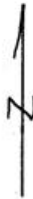

Monument Set (Procedures and Description)

New Accessories

Set 4 5/8" x 30" iron pins with yellow plastic caps marked "UMA CO R D LS 2627", one in each quadrant, with "Please do not disturb" and bearing object tags near each.

Location & Comments

Surveyor's Seal

In the intersection of Compass Declination

West Punkin Center Firm/Agency Umatilla Co. Road Dept.

Road and Geer Road

near Hermiston. Address 3920 Westgate

RECEIVED BY Pendleton, Oregon 97801

Umatilla County Surveyor Party Chief Gary Roberts

Date 5-95 Notes Gary Roberts

Rec'd by KK Witness Chris Amsberry

No. 95-80-R

**REGISTERED
PROFESSIONAL
LAND SURVEYOR**

Jay R. Roberts
OREGON
JULY 20, 1993
GARY R. ROBERTS
2627