

OREGON CORNER RESTORATION FORM

SECTION 13,18 TOWNSHIP 4 NORTH RANGE 27,28 EAST L-1
 COUNTY : UMATILLA DATE AUG/21

CORNER DESIGNATION
 1/4 CORNER

- CONDITION REPORT ONLY
- NOT FOUND
- RENEWED
- UNCOVERED
- SURVEYED IN
- REFERENCED

PREVIOUS RENEWALS / SURVEYS, ETC.


SURVEYED IN 1860 BY HAFT. SURVEYED IN 1941 BY GOULD. LS 951 RESET THIS MONUMENT IN 1999 FROM GOULDS BRASS CAP WITNESS CORNER. SEE OREGON CORNER RESTORATION FORM L-1 IN 1999 BY LS 951.

MONUMENTS AND ACCESSORIES FOUND: CONDITION AND SOURCE


I RECOVERED THE CORNER AND COMPARED ITS LOCATION WITH DUAL MONUMENTATION IN THE AREA AS REQUESTED. PLEASE REFER TO TO RECORD OF SURVEY THAT WAS RECORDED ALONG WITH THIS CORNER RESTORATION FORM FOR MY ANALYSES. THE ACCESSORIES FOR THE CORNER WERE NOT RECOVERED DURING THIS SURVEY DUE TO THE FACT IT HAD NO BEARING ON THE CORNERS LOCATION. PLEASE REFER TO SURVEY NUMBER 19-080-C AND THE CORNER RESTORATION FORMS RECORDED WITH SAID RECORD OF SURVEY FOR ACCESSORY INFORMATION.

MONUMENT DETAIL

SKETCH

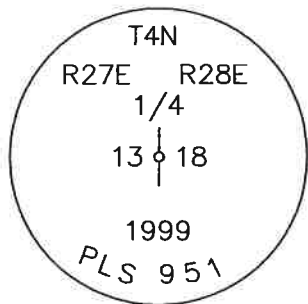

NAD 83/91
 OREGON STATE PLANE
 INTERNATIONAL FEET
 790094.73
 8489524.71

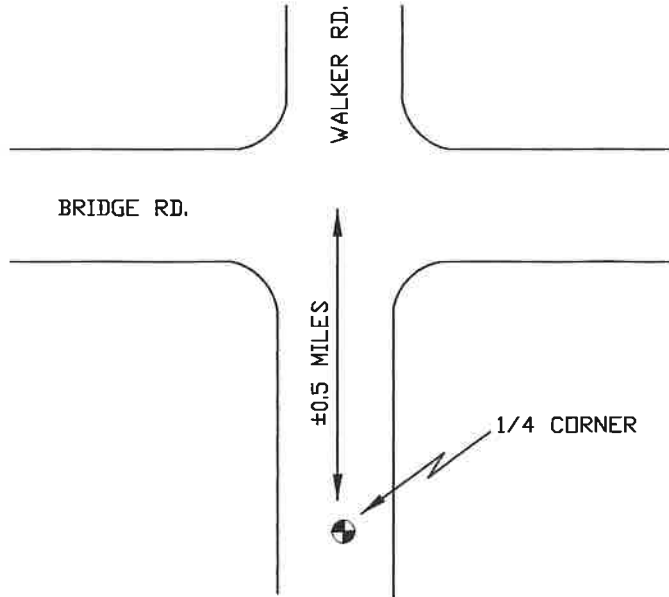

MONUMENT SET (PROCEDURES AND DESCRIPTION)

NEW ACCESSORIES FROM WHICH

LOCATION AND COMMENTS

FROM THE INTERSECTIONS OF WALKER ROAD AND BRIDGE ROAD GO SOUTHERLY ±0.5 MILES TO THE CORNER.

FIRM/AGENCY

PRIMM LAND SURVEYING, INC.
 P.O. BOX 1322
 HERMISTON, OREGON 97838

LAND SURVEYOR

BRIT L. PRIMM

WITNESS

KEITH P. PRIMM

SURVEYOR'S SEAL

REGISTERED
 PROFESSIONAL
 LAND SURVEYOR

OREGON
 JULY 13, 1999
 BRIT L. PRIMM
 48509

EXPIRATION DATE: 12/31/22