

OREGON CORNER RESTORATION FORM

SECTION 13 TOWNSHIP 4 NORTH RANGE 27 EAST N-25

COUNTY : UMATILLA DATE 10-2002

CORNER DESIGNATION

SOUTHEAST CORNER

- CONDITION REPORT ONLY
- NOT FOUND
- RENEWED
- UNCOVERED
- SURVEYED IN
- REFERENCED


PREVIOUS RENEWALS / SURVEYS, ETC.

ORIGINAL SURVEY BY HAFT IN 1860. CONTRACT #93.
 DEPENDENT RESURVEY BY GOULD IN 1941.
 IN 1999 EDWARDS SET 5/8"X30" IRON REBAR WITH 2" ALUM. CAP FROM GOULD WITNESS CORNER
 & IN PLACE OF A 3/4"X8" IRON PIPE.

MONUMENTS AND ACCESSORIES FOUND: CONDITION AND SOURCE

FOUND A 5/8"X30" IRON REBAR 4" BELOW THE SURFACE OF THE ROAD WITH A 2" ALUMINUM CAP
 STAMPED AS BELOW.
 FOUND 2 1/2" B.C. W.C. 16.50 FEET WEST, GOULD 1941, STAMPED 25W
 (MEANS 25 LINKS OR 16.50 FEET).
 FOUND A 1"X30" PIPE WITH A 2 3/8" BRASS CAP BEARS S 89°53' E 40.00 FEET.
 FOUND A 5/8" IRON REBAR BEARS S 89°53' E 668.49 FEET.
 FOUND AN ALUMINUM TAG STAMPED #951 ON A POWER POLE BEARS S 21°06' W 42.57 FEET.


MONUMENT DETAIL

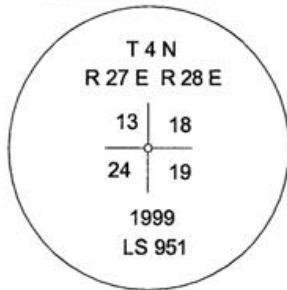

NAD 83/91
 OREGON STATE PLANE
 INTERNATIONAL FEET
 787452.9679
 8489557.2837



SKETCH

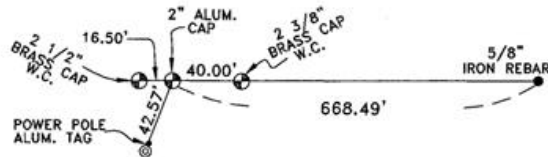

MONUMENT SET (PROCEDURES AND DESCRIPTION)

NA

NEW ACCESSORIES FROM WHICH

NA

LOCATION AND COMMENTS

AT THE INTERSECTION OF WALKER
 ROAD AND BRIDGE ROAD GO SOUTH
 1 MILE TO CORNER.

COMPASS DEC.

FIRM/AGENCY
 EDWARDS SURVEYING
 P.O. BOX 763
 HERMISTON, OREGON 97838

PARTY CHIEF
 CURTIS FAVOREL

NOTES

WITNESS
 RICK SMITH

SURVEYOR'S SEAL

REGISTERED
 PROFESSIONAL
 LAND SURVEYOR

G. Dennis Edwards

OREGON
 JULY 16, 1971
 G. DENNIS EDWARDS
 9 5 1
 RENEWS 12/31/2003

03-50-9