

CORNER RESTORATION FORM

Township 4N Range 28E Section 19, 20 County UMATILLA

State OREGON Date 6-4-2019 Number P-5

Corner Designation : 19, 20

Previous Renewals ORIGINAL SOURCE OF CORNER

ORIGINALLY SURVEYED IN 1860 BY HAFT UNDER CONTRACT #93. HE SET POST IN

BOUND WITH TRENCH, MADE PITS AND DEPOSITED A PINT OF CHARCOAL.

Accessories Found: _____

NONE.

Condition Report Only

Not Found

Renewed

Surveyed In

Referenced


MONUMENT DETAIL

Found Set

BASIS OF BEARINGS, NAD 83/91 OREGON STATE PLANE
COORDINATES NORTH ZONE:

NORTHING: 784864.95

EASTING: 8494673.30

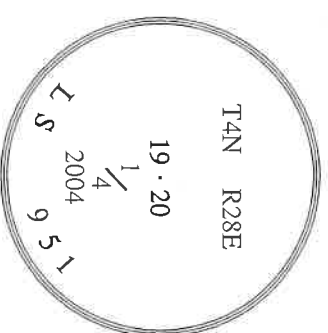

Monument & Accessories Set (Procedure and Description)

FOUND 2" ALUMINUM CAP AT A.C. GRADE AS PER COUNTY SURVEY 05-44-C.

SET 5/8" x 10" REBAR & CAP PLS 61420 1' BELOW GRADE, 1' WEST OF POWER POLE, N06°51'E 206.66 FT.

SET 5/8" x 10" REBAR & CAP PLS 61420 1' BELOW GRADE, 1' WEST OF POWER POLE, N89°44'E 35.90 FT.

SET 5/8" x 10" REBAR & CAP PLS 61420 1' BELOW GRADE, S25°14'W 37.96 FT.

SET 5/8" x 10" REBAR & CAP PLS 61420 1' BELOW GRADE, N19°58'W 49.84 FT.

Sketch of Monument, Accessories and General Area

**REGISTERED
PROFESSIONAL
LAND SURVEYOR**

Lance Clark King

**OREGON
MAY 10, 2011
LANCE CLARK KING
61420**

Agency: CK3, LLC

945 W. ORCHARD
HEERMISTON OREGON 97838
OFFICE: 541-567-2345
FAX: 541-567-2305
WEB: CK3LLC.NET
Field Book # 0-325

RENEWS: 6/30/2021

**COUNTY SURVEYOR
RECORDING INFO**

Received _____

Filed _____

Survey No. _____

Drawing No. _____

Index No. P-5

19-080-C