

OREGON CORNER RESTORATION FORM

COUNTY: Umatilla DATE: May 24, 2005

CORNER DESIGNATION: X-25 E 1/4 Corner Section 36, T. 4 North,
Range 27 E.W.M.


PREVIOUS RENEWALS/SURVEYS ETC.

See Remonumentation Sheet 03-49-G by PLS48509

MONUMENT AND ACCESSORIES FOUND:

Found a 3/4" bolt approximately 13" deep on April 5, 2005.
The bolt is now 14" below the surface of a new A.C. overlay.
The accessories shown by PLS48509 on 03-49-G are still
intact, but were not tied.

MONUMENT MARKING DETAIL

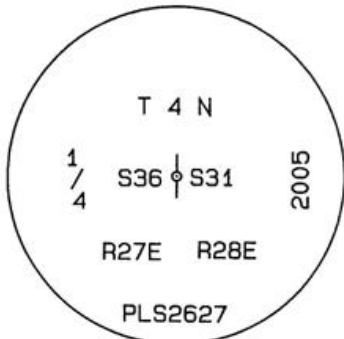

OREGON STATE PLANE COORDINATES.

NORTH ZONE, NAD'83 ('91), INT. FEET:

NORTH: 774232.81 (774232.83, RECORD, 03-49-G)

EAST: 8489727.16 (8489727.08, RECORD, 03-49-G)

MONUMENT SET (PROCEDURES AND DESCRIPTION):

Prior to road reconstruction, the 3/4" bolt was tied from GPS Station 0614, a 5/8" iron rebar with yellow plastic cap set by Caswell, Survey No. 94-171-G. After road reconstruction was completed, set a 5/8" X 12" iron rebar with 2" aluminum cap marked as shown in monument marking detail flush with asphalt road surface.

LOCATION AND COMMENTS:

From the Westland Interchange on Interstate 84, travel south on Colonel Jordan Road to its intersection with Noble Road. Monument is set in the intersection.

COMPASS DECLINATION:

N/A

FIRM/AGENCY:

Umatilla County Road Dept.
3920 Westgate
Pendleton, Oregon 97801

PARTY CHIEF:

Gary Roberts

NOTES:

WITNESS:

NEW ACCESSORIES:

None

SURVEYOR'S SEAL

REGISTERED
PROFESSIONAL
LAND SURVEYOR

Gary R. Roberts

OREGON
JULY 30, 1993
GARY R. ROBERTS
2627

RENEWS 12/31/06

RECEIVED BY

Umatilla County Surveyor

Date 5-05

Rec'd By RR

No. 05-114-R