

OREGON CORNER RESTORATION FORM

Section 6 Township 4 N Range 29 E

A-5

County UMATILLA Date 3/95

CORNER DESIGNATION

NE Cor.

- Condition Report Only
- Not Found
- Renewed
- Unrecorded
- Surveyed In
- Referenced Out

Previous Renewals/Surveys, etc. ORIG SUR. DAVENPORT 1861 # 101


He set a post in mound with charred stake

Kimbrell set 1/2" Iron Pipe in 1910

Monument(s) & Accessories Found: (Condition and Source)

Find 5/8" rebar that Cramer set over Kimbrell 1/2" Iron Pipe.

Monument Detail

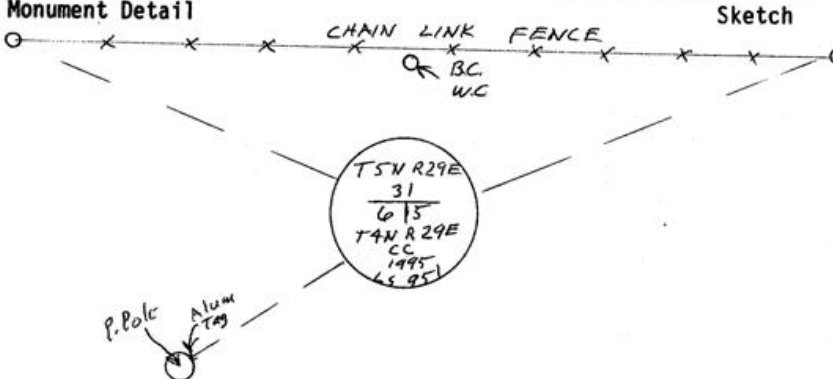

Monument Set (Procedures and Description)

I set a 2" Alum Cap on Cramer's 5/8" rebar stamped as above

SEE MY 1992-1 COUNTY PUBLIC MONUMENTATION SUR.

New Accessories

Center of 2 1/4" OD IPipe Fence Cor. Bears N 81° 46' 10" E 94.42 FT

Center of 2 1/4" OD IPipe Fence Cor. Bears N 77° 39' 10" W 60.26 FT

Alum tag # 951 in P. Pole Bears S 45° 12' 50" W 49.22 FT

1" x 30" IP with 2 3/8" B.C. Stamped as above & W.C. Bears N 0° 19' 55" E 1180 FT

Location & Comments

AT Intersection

Punkin Center &

Canal Rd.

Compass Declination _____

Firm/Agency EDWARDS

SURVEYING

Address P. Box 763

HERMISTON, OR 97038

Party Chief D. EDWARDS

Notes _____

Witness J. COPPOCK

Surveyor's Seal

REGISTERED PROFESSIONAL LAND SURVEYOR

G. Dennis Edwards

OREGON JULY 16, 1971 G. DENNIS EDWARDS 951

RENEWS 12/31/95

RECEIVED BY _____

Umatilla County Surveyor

Date 4-95

Rec'd by KR

No. 95-59B