

OREGON CORNER RESTORATION FORM

SECTION 23 TOWNSHIP 4 NORTH RANGE 29 EAST N-19
 COUNTY : UMATILLA DATE 11-2001

CORNER DESIGNATION

NORTH 1/4

- CONDITION REPORT ONLY
- NOT FOUND
- RENEWED
- UNCOVERED
- SURVEYED IN
- REFERENCED

PREVIOUS RENEWALS / SURVEYS, ETC.


ORIGINALLY SURVEYED IN 1861 BY DAVENPORT UNDER CONTRACT #101. HE SET A POST IN A MOUND OF EARTH AND A CHARRED STAKE.
 IN 1998 I SET A 5/8"X30" IRON REBAR WITH 2" ALUMINUM TAG STAMPED AS BELOW. (SEE CO. MON. SURVEY 1996-2)

MONUMENTS AND ACCESSORIES FOUND: CONDITION AND SOURCE

FOUND A 5/8" IRON REBAR WITH 2" ALUMINUM CAP STAMPED AS BELOW.
 FROM WHICH:

AN ALUMINUM TAG STAMPED 951 IN FACE OF A 20" MAPLE TREE BEARS N 49°20'17" E 32.12 FEET.
 AN ALUMINUM TAG STAMPED 951 IN FACE OF A 28" LOCUST TREE BEARS S 82°55'49"E 29.62 FEET.
 A 5/8" IRON REBAR WITH PLASTIC CAP #951 BEARS S 89°55'39" W 17.86 FEET.


MONUMENT DETAIL

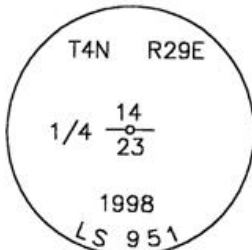

NAD 83/91
 OREGON STATE PLANE
 INTERNATIONAL FEET
 788228.9467
 8545460.4691



SKETCH

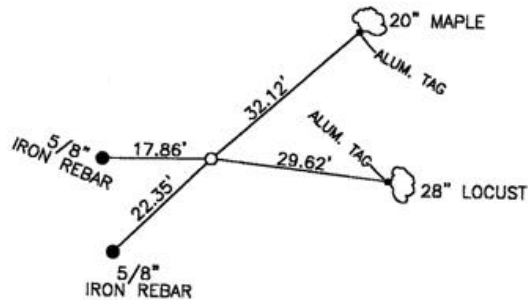

MONUMENT SET (PROCEDURES AND DESCRIPTION)

NEW ACCESSORIES FROM WHICH

A 5/8"X30" IRON REBAR WITH PLASTIC CAP #951 LIES S 46°02'16" W 22.35 FEET

RECEIVED BY

Umatilla County Surveyor

Date 12-01

Rec'd By KE

No. 01-213-9

SURVEYOR'S SEAL

LOCATION AND COMMENTS
 CENTERLINE OF LOOP ROAD, 1
 MILE NORTH OF FEEDVILLE ROAD.

COMPASS DEC.

FIRM/AGENCY
 EDWARDS SURVEYING
 P.O. BOX 763
 HERMISTON, OREGON 97838

PARTY CHIEF
 D. EDWARDS

NOTES

WITNESS
 CURTIS J FAVOREL

REGISTERED
 PROFESSIONAL
 LAND SURVEYOR

G. Dennis Edwards

OREGON
 JULY 16, 1971
 G. DENNIS EDWARDS
 9 5 1
 RENEWS 12/31/2001