

CORNER RESTORATION FORM

Township 4N Range 29E Section 13, 24 County UMATILLA

State OREGON Date 3/30/2023 Number N-23


- Condition Report Only
- Not Found
- Renewed
- Surveyed In
- Referenced

Corner Designation : 1/4 CORNER: 13, 24

Previous Renewals	ORIGINAL SOURCE OF CORNER
ORIGINALLY SURVEYED IN 1861 BY DAVENPORT UNDER	
CONTRACT #101, HE SET A STAKE IN MOUND OF EARTH	
1998 EDWARDS SET A 1"X30" I.P. W/2 3/8" BRASS CAP BY	
SINGLE PROPORTION COUNTY SURVEY NO. 98-213-C &	
CORNER FORM NO. N23-98-213-C	
2013 EDWARDS SET A 1"X15" I.P. W/2 1/2" BRASS CAP BY	
SINGLE PROPORTION COUNTY SURVEY NO. 13-532-C &	
CORNER FORM NO. N23-13-532-C	

MONUMENT DETAIL

Found Set

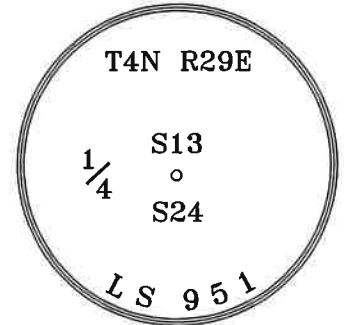

BASIS OF BEARINGS, NAD 83/91 OREGON STATE PLANE COORDINATES NORTH ZONE:

NORTHING: 788317.13
EASTING: 8550747.77

Monument & Accessories Set/Found (Procedure and Description)

- AT CORNER FOUND A 2 3/8" BRASS CAP 2' BELOW GRADE IN FIELD, COUNTY SURVEY NO. 13-532-C
- FOUND A 5/8" I.R. W/YPC 951 4" DEEP N 60°41' W 178.57', CORNER FORM NO. N23-13-532-C
- FOUND A 5/8" I.R. W/YPC 951 4" DEEP N 06°14' W 229.82', CORNER FORM NO. N23-13-532-C
- FOUND A 5/8" I.R. W/YPC 951 4" DEEP S 85°45' W 315.58', CORNER FORM NO. N23-313-532-C
- FOUND A SCRIBED X ON CORNER OF A CONC. PAD IN METAL PIVOT LEG & SET UMATILLA MON. SIGN S 44°34' E 538.35', CORNER FORM NO. N23-13-532-C

Sketch of Monument, Accessories and General Area

The sketch shows a central point with four bearings and distances to other points: 178.57' N 60°41' W, 229.82' N 06°14' W, 315.58' S 85°45' W, and 538.35' S 44°34' E. A 'DIRT RD.' is shown near the 178.57' point. A 'CONC. PAD.' is shown at the end of the 538.35' line. A 'SCRIBED X ON CONC. PAD IN METAL LEG FOR PIVOT & UMATILLA MON. SIGN' is noted at the end of the 538.35' line. The area is labeled 'FIELD'.

REGISTERED PROFESSIONAL LAND SURVEYOR

Lance Clark King

OREGON
MAY 10, 2011
LANCE CLARK KING
61420

RENEWS: 6/30/2023

Agency:
CK3, LLC
945 W. ORCHARD
HERMISTON OREGON 97838
OFFICE: 541-567-2345
FAX: 541-567-2305
WEB: CK3LLC.NET
Field Book # 0-350

COUNTY SURVEYOR RECORDING INFO

Received CT

Filed 5/4/23

Survey No. 23-042-C

Drawing No. _____

Index No. N-23