

CORNER RESTORATION FORM

Township 4N Range 29E Section 21,22,27,28 County UMATILLA

State OREGON Date 3/30/2023 Number R-13

Corner Designation : SECTION CORNER: 21, 22, 27, 28

Condition Report Only

Not Found

Renewed


Surveyed In

Referenced

Previous Renewals	ORIGINAL SOURCE OF CORNER
ORIGINALLY SURVEYED IN 1861 BY DAVENPORT UNDER	
CONTRACT #101, HE SET A STAKE IN MOUND OF EARTH	
1975 PALMER SET A R.R. SPIKE COUNTY SURVEY NO.	
03-272-C	
1995 EDWARDS SET A 1"X30" I.P. W/2 3/8" B.C. BY	
DOUBLE PROPORTION COUNTY SURVEY NO. 95-060-B &	
CORNER FORM NO. R13-95-060-B	

MONUMENT DETAIL

Found Set

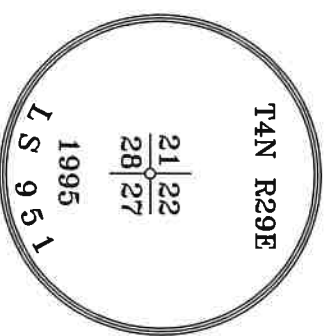

BASIS OF BEARINGS, NAD 83/91 OREGON STATE PLANE
COORDINATES NORTH ZONE:

NORTHING: 782750.31
EASTING: 8537570.50

Monument & Accessories Set/Found (Procedure and Description)

- AT CORNER FOUND A 2 3/8" BRASS CAP 3" BELOW GRADE, COUNTY SURVEY NO. 95-060-B & CORNER FORM NO. R13-95-060-B
- FOUND A ALUMINUM TAG 951 ON RAILROAD TIE S 02°20' E 17.94', CORNER FORM NO. R13-95-060-B
- FOUND A ALUMINUM TAG 951 ON RAILROAD TIE N 33°51' W 62.36', CORNER FORM NO. R13-95-060-B
- FOUND A 1"X30" IRON PIPE W/ 2-3/8" BRASS CAP & UMATILLA MON. SIGN N 00°41' W 40.07', CORNER FORM NO. R13-95-060-B
- FOUND A MILE #20 METAL POST N 59°15' W 71.87'
- FOUND A 5/8" I.R. NO CAP BENT RESTRAIGHTENED S 82°12' W 17.52' ORIGIN UNKNOWN

**REGISTERED
PROFESSIONAL
LAND SURVEYOR**

Lance Clark/King

**OREGON
MAY 10, 2011
LANCE CLARK/KING
61420**

Sketch of Monument, Accessories and General Area

AGENCY:
CK3, LLC
945 W. ORCHARD
HERMISTON OREGON 97838
OFFICE: 541-567-2345
FAX: 541-567-2305
WEB: CK3LLC.NET
Field Book # 0-350

RENEWALS: 6/30/2023

**COUNTY SURVEYOR
RECORDING INFO**

Received CT

Filed 5/4/23

Survey No. 23-042-C

Drawing No. _____

Index No. R-13