

CORNER RESTORATION FORM

Township 4N Range 29E Section 25, 36 County UMATILLA

State OREGON Date 3/30/2023 Number V-23

Corner Designation : 1/4 CORNER: 25, 36

Condition Report Only

Not Found
 Renewed

Surveyed In
 Referenced


MONUMENT DETAIL

Found Set

Previous Renewals ORIGINAL SOURCE OF CORNER
 ORIGINALLY SURVEYED IN 1861 BY DAVENPORT UNDER
 CONTRACT #101, HE SET A STAKE IN MOUND OF EARTH
 1998 EDWARDS SET A 1"X30" I.P. W/2 3/8" BRASS CAP BY
 SINGLE PROPORTION COUNTY SURVEY NO. 98-213-C &
 CORNER FORM NO. V23-98-213-C

BASIS OF BEARINGS, NAD 83/91 OREGON STATE PLANE
 COORDINATES NORTH ZONE:

NORTHING: 777754.88
 EASTING: 8550892.90

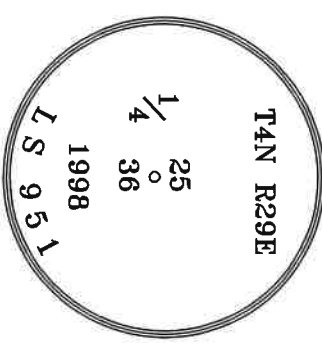

Monument & Accessories Set/Found (Procedure and Description)

FOUND A 2 3/8" BRASS CAP 20" BELOW GRADE IN FIELD, COUNTY SURVEY NO. 98-213-C & CORNER FORM NO. V23-98-213-C


FOUND A 1"X30" IRON PIPE W/ 2-3/8" BRASS CAP W.C. N 88°54' E 533.19', CORNER FORM NO. V23-98-213-C

FOUND A 5/8" IRON ROD NO CAP S 01°20' E 977.13', CORNER FORM NO. V23-98-213-C

FOUND A 5/8" IRON ROD NO CAP S 44°56' E 577.19', CORNER FORM NO. V23-98-213-C

SET A 5/8" I.R. W/RPC "PLS 61420" & UMATILLA MON. SIGN NEXT TO PIVOT PAD S 27°43 E 627.66'

Sketch of Monument, Accessories and General Area

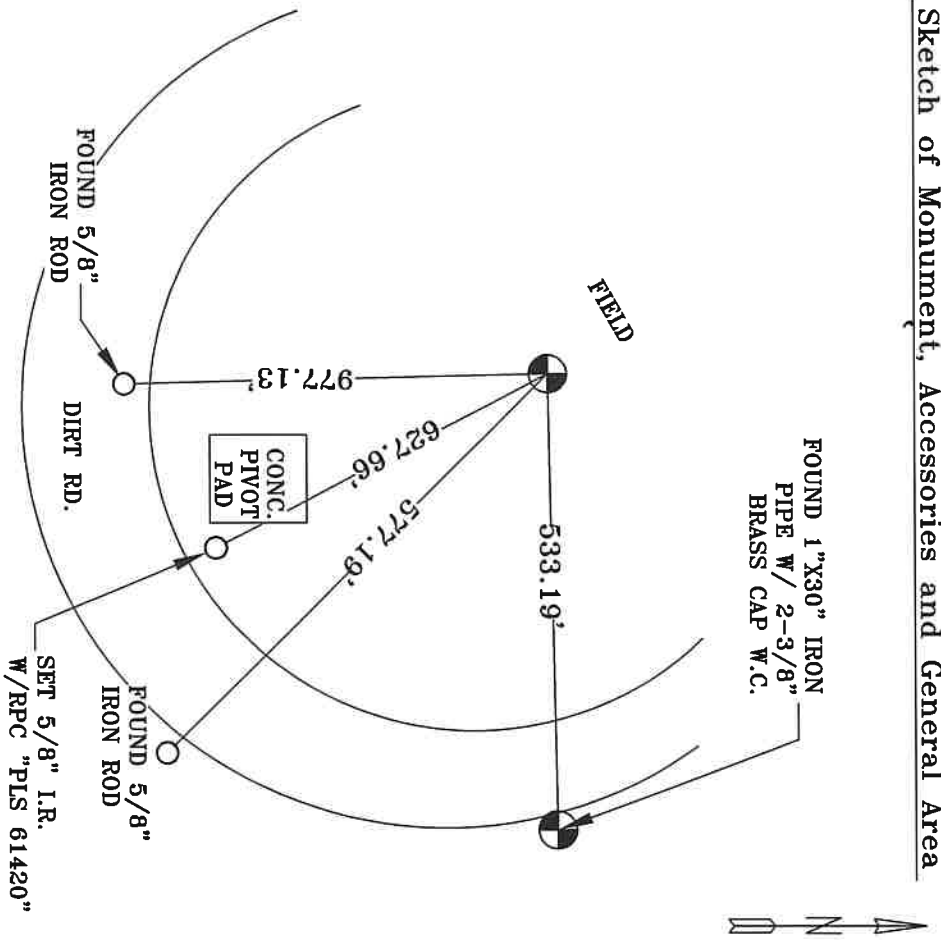

REGISTERED PROFESSIONAL LAND SURVEYOR

[Signature]

OREGON
 MAY 10, 2011
 LANCE CLARK KING
 61420

RENEWALS: 6/30/2023

Agency:
 CK3, LLC
 945 W. ORCHARD
 HERMISTON OREGON 97838
 OFFICE: 541-567-2345
 FAX: 541-567-2305
 WEB: CK3LLC.NET
 Field Book # 0-350

COUNTY SURVEYOR RECORDING INFO

Received CT
 Filed 5/4/23
 Survey No. 23-042-C
 Drawing No. _____
 Index No. V-23