

GPS CONTROL STATION

OREGON STATE PLANE, NORTH ZONE

STATION NAME: 4N29V3 GEODETIC COORDINATE: NAD 83(91)

SECTION: S 1/4 S30  
T. 4N., R. 29 E., W. M. LAT: 45°47'28.85783" N  
UMATILLA COUNTY LONG: 119°14'9.55415" W  
OREGON

STATE PLANE CO-ORDINATES,  
NAD 83-91, INT. FT. :

DATE SURVEYED: March, 1998

N: 777141.423

SURVEYOR: DAVID L. HADDOCK  
PLS 852

E: 8524519.090

THETA: 0°53'47.11"

SCALE FACTOR: 0.99995465

ELEV: 635

FIRM: HADDOCK SURVEYING  
P. O. BOX 1574  
PENDLETON, OR 97801  
(541) 276-2174

ELEV. DATUM: NGVD29

HORIZONTAL ORDER: SECOND ORDER,  
CLASS I

---

LOCATION: From Wood Street in the City of Stanfield go northwest along the north side of the rail road tracks on the access road to the Hinkle train yard approximately 3/4 of a mile. There is an access road connecting the railroad access road to the road along the south bank of the USRS canal. The cap is in the road on the south bank of the canal approximately 100 yards north of the rail road access road.

STATION: Station is a 2 1/4 inch brass disc on a galvanized iron pipe approximately 10 inches below the surface of the ground.

REGISTERED  
PROFESSIONAL  
LAND SURVEYOR

*David L. Haddock*

OREGON  
JULY 12, 1966  
DAVID L. HADDOCK  
852

---

98-155-C

OREGON CORNER RECONSTRUCTION FORM

Section 30 Township 4N Range 29E  
 County Umatilla Date: March 21, 1998

Corner Designation: 4N29V3

1/4 corner common to sections 30 and 31,  
 T4N, R29E, W.M.



Condition Report Only  
 Not found  
 Remonumented  
 Unrecorded  
 Surveyed in  
 Referenced out

Previous Renewals / Surveys, etc.

Original corner set by Davenport in contract #101 in 1861 which was a post in a mound with charred stake. A brass cap was set in 1973 in survey I-21-C by PLS 933. This brass cap was found and references set as outlined in the corner certification by PLS 951 in the public monumentation survey No. 95-60-B

Monument and Accessories found: ( condition and source )

The brass cap had been rooted out by ditch maintenance and was lying in a berm of dirt west of the corner. The references set by PLS 951 were still in good condition.

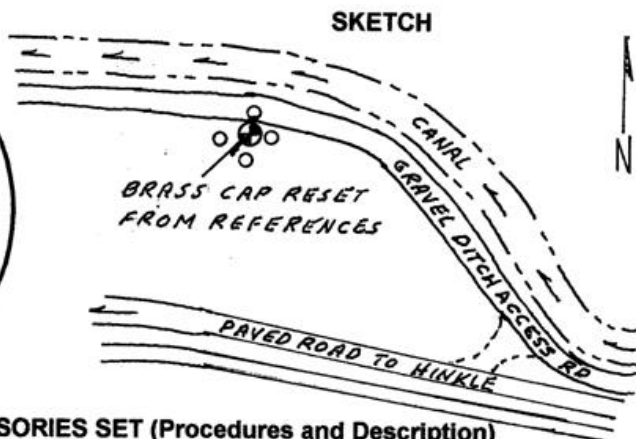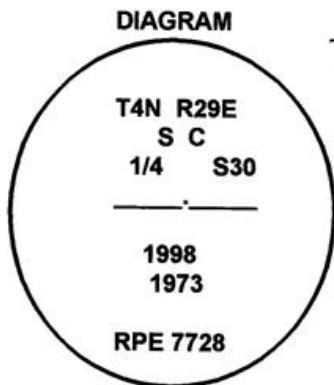

MONUMENT (S) AND ACCESSORIES SET (Procedures and Description)

Reset the brass cap from the existing references and stamped the date in it as shown above.

REFERENCES SET:

None:

Location and comments

Compass Declination

Surveyors Seal

RECEIVED BY:  
 Umatilla County Surveyor  
 Date: 8-98  
 Rec'd By: KK  
 No. 98-155-C

Firm / Agency  
 Haddock Surveying  
 Address  
 P.O. Box 1574  
 Pendleton, Or. 97801  
 Party Chief  
 Stephen K, Haddock

REGISTERED  
 PROFESSIONAL  
 LAND SURVEYOR

*David L. Haddock*

OREGON  
 JULY 12, 1968  
 DAVID L. HADDOCK  
 852

RECEIVED BY  
 Umatilla County Surveyor  
 Date \_\_\_\_\_  
 Rec'd By \_\_\_\_\_  
 No. \_\_\_\_\_