

# CORNER RESTORATION FORM

Township 4N Range 29E Section 29, 32 County UMATILLA

State OREGON Date 3/30/2023 Number V-7

Corner Designation : 1/4 CORNER: 29, 32

Condition Report Only

Not Found

Renewed

Surveyed In

Referenced


Previous Renewals ORIGINAL SOURCE OF CORNER  
 ORIGINALLY SURVEYED IN 1861 BY DAVENPORT UNDER  
 CONTRACT #101, HE SET A STAKE IN MOUND OF EARTH  
 1950 FRALEY SET A 1 1/2" I.P. COUNTY SURVEY NO.  
 Q-0695-AX  
 1974 KRUMBEIN SET A 2 1/2" BRASS CAP IN PLACE OF  
 FRALEY I.P. COUNTY SURVEY NO. I-026-B  
 1980 KRUMBEIN SET A BRASS CAP COUNTY SURVEY NO.  
 S-158-C

### MONUMENT DETAIL

Found  Set

BASIS OF BEARINGS, NAD 83/91 OREGON STATE PLANE  
 COORDINATES NORTH ZONE:


NORTHING: 777244.00  
 EASTING: 8529795.07

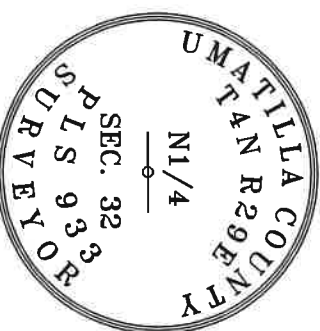

### Monument & Accessories Set/Found (Procedure and Description)

- AT CORNER FOUND 2 1/2" BRASS CAP 9" BELOW SURFACE, COUNTY SURVEY NO. S-158-C
- FOUND A ALUMINUM TAG 951 ON POWER POLE & SET UMATILLA MON. SIGN S 28°19' E 59.47', CORNER FORM V7-95-060-B
- FOUND A 5/8" IRON ROD W/YELLOW PLASTIC CAP 1.5' BELOW GRADE "PLS LS 48509" N 70°07' W 18.61', CORNER FORM NO. V7-02-049-G
- FOUND A 5/8" IRON ROD W/YELLOW PLASTIC CAP 1.0' BELOW GRADE "PLS LS 48509" N 76°23' E 23.80', CORNER FORM NO. V7-02-049-G
- FOUND BLUE "DEEP-1" MAGNET BURIED 2" BELOW SURFACE S 35°51' W 27.72', CORNER FORM NO. V7-13-562-B

### Sketch of Monument, Accessories and General Area

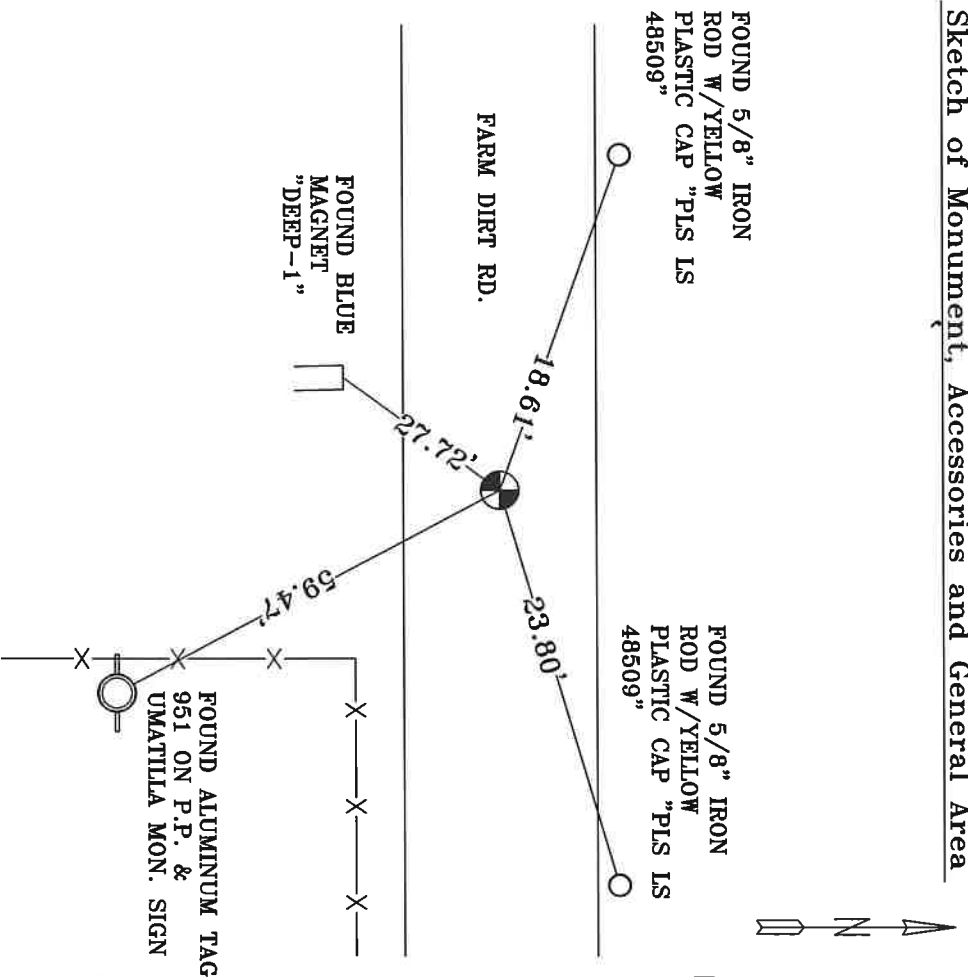

**REGISTERED  
 PROFESSIONAL  
 LAND SURVEYOR**

**OREGON**  
 MAY 10, 2011  
 LANCE CLARK/KING  
 61420

**RENEWALS: 6/30/2023**

Agency: **CK3, LLC**  
 945 W. ORCHARD  
 HERMISTON OREGON 97838  
 OFFICE: 541-567-2345  
 FAX: 541-567-2305  
 WEB: CK3LLC.NET  
 Field Book # 0-350

**COUNTY SURVEYOR  
 RECORDING INFO**

Received CT  
 Filed 5/4/23  
 Survey No. 23-042-C  
 Drawing No. \_\_\_\_\_  
 Index No. V-7