

CORNER RESTORATION FORM

Township 4N Range 29E Section 34, 35 County UMATILLA

State OREGON Date 3-30-2023 Number X-17

Condition Report Only

Corner Designation : 1/4 CORNER: 34, 35

Not Found
 Renewed

Previous Renewals ORIGINAL SOURCE OF CORNER

Surveyed In
 Referenced

ORIGINALLY SURVEYED IN 1861 BY DAVENPORT UNDER

CONTRACT #101, HE SET A STAKE IN MOUND OF EARTH

MONUMENT DETAIL

1998 EDWARDS SET A 1"X30" I.P. W/2 3/8" BRASS CAP BY

Found Set


SINGLE PROPORTION COUNTY SURVEY NO. 98-213-C &

T4N R29E
1/4

CORNER FORM NO. X17-98-213-C

BASIS OF BEARINGS, NAD 83/91 OREGON STATE PLANE
COORDINATES NORTH ZONE:

NORTHING: 774954.85
EASTING: 8542995.30

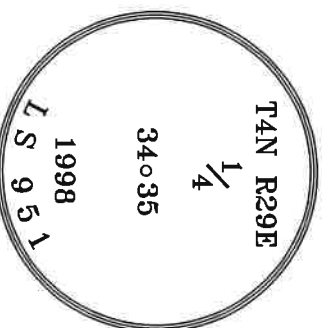

Monument & Accessories Set/Found (Procedure and Description)


AT CORNER FOUND A 2 3/8" BRASS CAP 1.5' BELOW GRADE, COUNTY SURVEY NO. 98-213-C & CORNER FORM NO. X17-98-213-C

FOUND A ALUMINUM TAG 951 ON RAILROAD THE LEANING WEST (POST IS TILL SOLID) RECORD DISTANCE IS SUBSTANTIALLY DIFFERENT FROM EXISTING & SET UMATILLA MON. SIGN S 17°16' E 26.73', CORNER FORM NO. X17-98-213-C

FOUND A 5/8" IRON ROD W/YELLOW PLASTIC CAP 951 1.5' BELOW GRADE S 23°13' E 29.06', CORNER FORM NO. X17-98-213-C

FOUND A ALUMINUM TAG 951 ON POWER POLE N 00°25' E 161.37', CORNER FORM NO. X17-98-213-C
SET A 5/8" I.R. W/RPC "PLS 61420" 2" BELOW GRADE S 84°58' W 16.63'

Sketch of Monument, Accessories and General Area

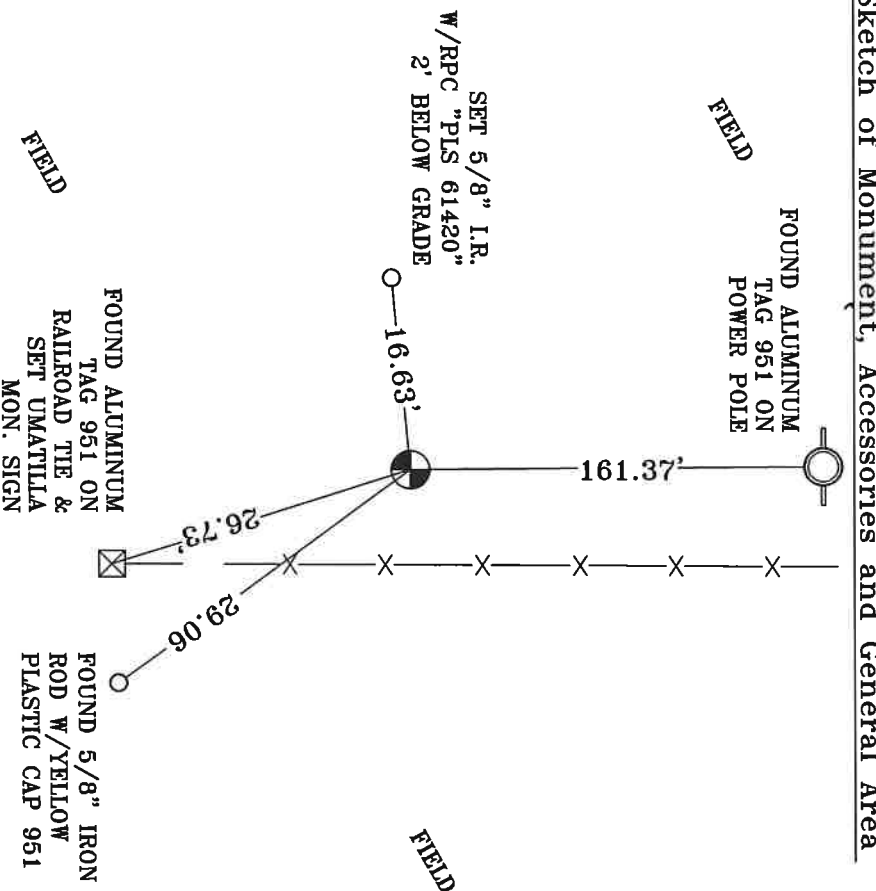

**REGISTERED
PROFESSIONAL
LAND SURVEYOR**

Lance Clark King
**OREGON
MAY 10, 2011
LANCE CLARK KING
61420**

RENEWALS: 6/30/2023

Agency:

CK3, LLC
945 W. ORCHARD
HERMISTON OREGON 97838
OFFICE: 541-567-2345
FAX: 541-567-2305
WEB: CK3ILC.NET
Field Book # 0-350

**COUNTY SURVEYOR
RECORDING INFO**

Received CT
Filed 5/4/23
Survey No. 23-042-C
Drawing No. _____
Index No. X-17