

CORNER RESTORATION FORM

Township 4N Range 29E Section 32, 33 County UMATILLA

State OREGON Date 3/30/2023 Number X-9

Corner Designation : 1/4 CORNER: 32, 33

Condition Report Only

Not Found

Renewed

Surveyed In

Referenced


MONUMENT DETAIL

Found Set

Previous Renewals ORIGINAL SOURCE OF CORNER
 ORIGINALLY SURVEYED IN 1861 BY DAVENPORT UNDER
 CONTRACT #101, HE SET A STAKE IN MOUND OF EARTH
 1949 FRALEY SET A 5/8" I.R. COUNTY SURVEY NO. Q-695-AX
 1980 KRUMBEIN SET A B.C. IN REPLACE OF 5/8" I.R. COUNTY
 SURVEY NO. S-158-C

BASIS OF BEARINGS, NAD 83/91 OREGON STATE PLANE
 COORDINATES NORTH ZONE:


NORTHING: 774663.06
 EASTING: 8532467.18

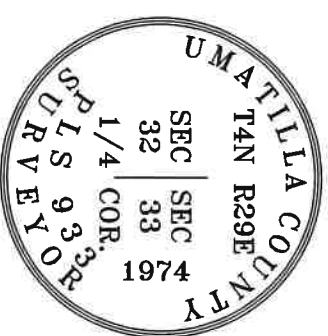

Monument & Accessories Set/Found (Procedure and Description)

AT CORNER FOUND A 2 1/2" BRASS CAP 4" BELOW ASPHALT, COUNTY SURVEY NO. S-158-C
 FOUND A ALUMINUM TAG 961 ON POWER POLE N 56°40' E 65.14', CORNER FORM NO. X9-95-60-B
 FOUND A 1 1/2" IRON PIPE BENT WEST TIED AT BEND NO CAP & SET A UMATILLA MON SIGN
 S 62°00' E 38.01', CORNER FORM NO. X9-95-60-B
 FOUND A 1/2"X24" IRON ROD NO CAP N 43°32' W 43.20', CORNER FORM NO. X9-95-60-B
 FOUND A 5/8" IRON ROD NO CAP BENT SOUTH TIED AT SPINHOLE S 74°55' W 61.17', CORNER FORM NO. X9-02-049-G

Sketch of Monument, Accessories and General Area

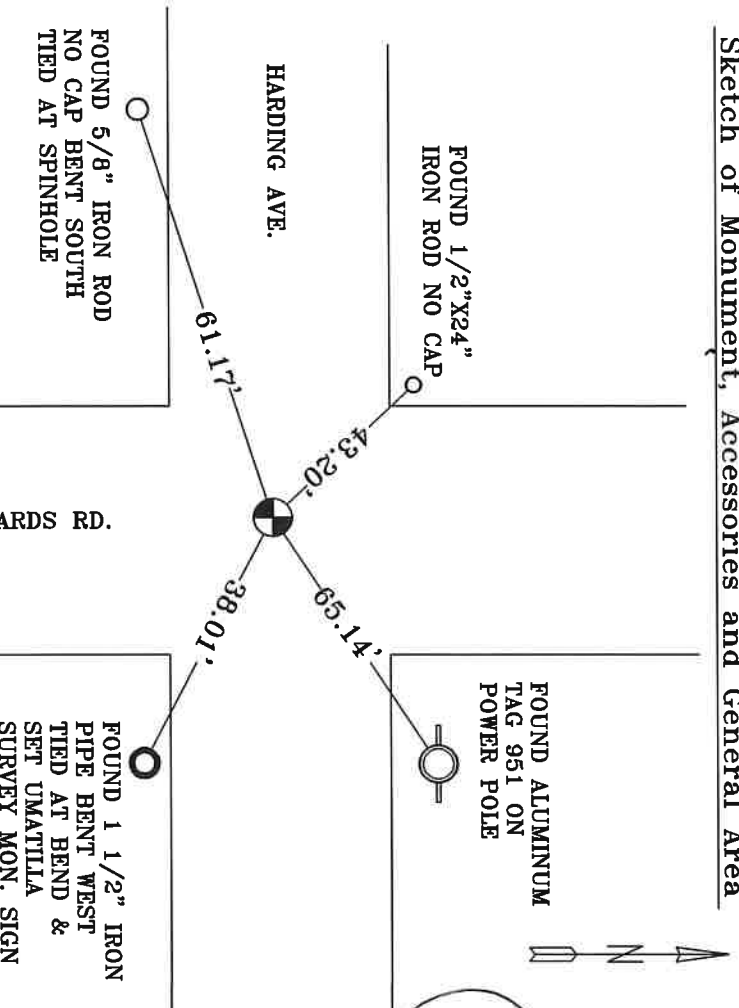

**REGISTERED
 PROFESSIONAL
 LAND SURVEYOR**

OREGON
 MAY 10, 2011
 LANCE CLARK KING
 61420

RENEWALS: 6/30/2023

Agency: **CK3, LLC**
 945 W. ORCHARD
 HERMISTON OREGON 97838
 OFFICE: 541-567-2345
 FAX: 541-567-2305
 WEB: CK3LLC.NET
 Field Book# 0-350

COUNTY SURVEYOR
 RECORDING INFO

Received CT

Filed 5/4/23

Survey No. 23-042-C

Drawing No. _____

Index No. X-9