

CORNER RESTORATION FORM

Township 3N, 4N Range 29E Section 3,4,33,34 County UMATILLA

State OREGON Date 3/30/2023 Number Z-13

Condition Report Only

Corner Designation : SECTION CORNER: 3, 4, 33, 34

Not Found
 Renewed

Previous Renewals ORIGINAL SOURCE OF CORNER

Surveyed In
 Referenced

ORIGINALLY SURVEYED IN 1859 BY GATES HE SET A POST IN MOUND OF EARTH

MONUMENT DETAIL

Found Set


1995 EDWARDS SET A 5/8" I.R. W/2" ALUMINUM CAP SET

OVER 24" CONC. PIPE RUNS N-S BENT I.R. WEST, COUNTY

SURVEY NO. 95-060-B & CORNER FORM NO. Z13-95-060-B

BASIS OF BEARINGS, NAD 83/91 OREGON STATE PLANE
COORDINATES NORTH ZONE:

NORTHING: 772166.28
EASTING: 8537749.42

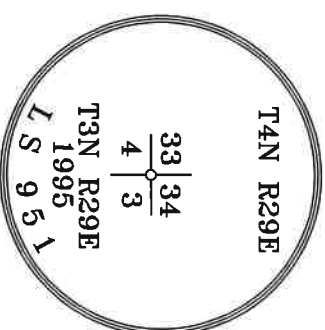

Monument & Accessories Set/Found (Procedure and Description)

AT CORNER FOUND A 2" ALUMINUM CAP 4" BELOW GRADE, COUNTY SURVEY NO. 95-060-B & CORNER FORM NO.

Z13-95-060-B

FOUND A 2 3/8" BRASS CAP WITNESS CORNER & UMATILLA MON. SIGN S 01°31' E 16.85', CORNER


FORM NO. Z13-95-60-B

FOUND A ALUMINUM TAG 951 IN POWER POLE N 22°17' W 38.77', CORNER FORM NO. Z13-95-60-B

FOUND A ALUMINUM TAG 951 IN POWER POLE S 21°13' W 17.32', CORNER FORM NO. Z13-95-60-B

SET 5/8" I.R. W/RPC "PLS 61420" 2" BELOW GRADE N 35°05' E 13.13'

Sketch of Monument, Accessories and General Area

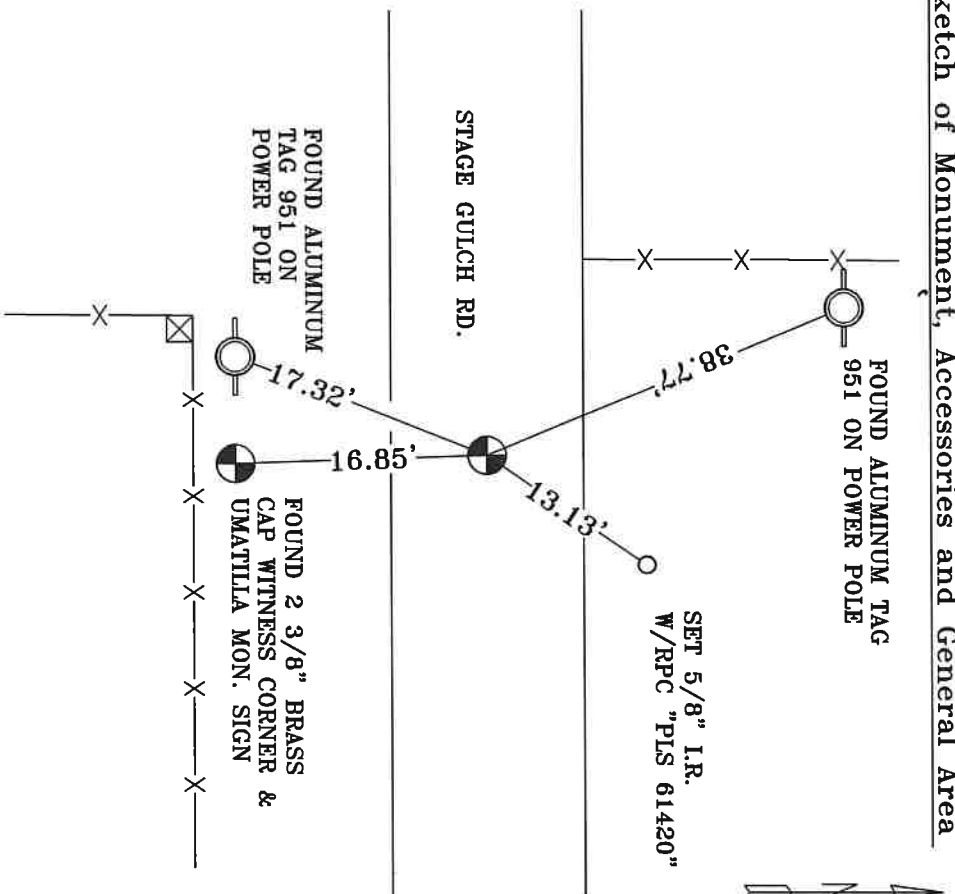

**REGISTERED
PROFESSIONAL
LAND SURVEYOR**

Lance Clark King
**OREGON
MAY 10, 2011
LANCE CLARK KING
61420**

RENEWALS: 6/30/2023

Agency:

CK3, LLC
945 W. ORCHARD
HERMISTON OREGON 97838
OFFICE: 541-567-2345
FAX: 541-567-2305
WEB: CK3ILLC.NET
Field Book # 0-350

COUNTY SURVEYOR
RECORDING INFO

Received CT

Filed 5/4/23

Survey No. 23-042-C

Drawing No. _____

Index No. Z-13