

CORNER RESTORATION FORM

Township 3N, 4N Range 29E Section 1, 36 County UMATILLA

State OREGON Date 3/30/2023 Number Z-23

Corner Designation : 1/4 CORNER: 1, 36

Condition Report Only

Previous Renewals ORIGINAL SOURCE OF CORNER

Not Found
 Renewed

ORIGINALLY SURVEYED IN 1859 BY GATES HE SET A POST
IN MOUND OF EARTH

Surveyed In
 Referenced

1998 EDWARDS SET A 1"X30" I.P. W/ 2-3/8" B.C. BY SINGLE

MONUMENT DETAIL


Found Set

PROPORTION COUNTY SURVEY NO. 98-213-C & CORNER FORM

NO. Z23-98-213-C

BASIS OF BEARINGS, NAD 83/91 OREGON STATE PLANE
COORDINATES NORTH ZONE:

NORTHING: 772474.36
EASTING: 8550997.09

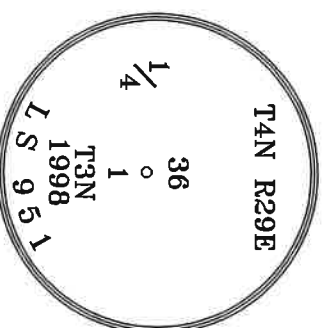

Monument & Accessories Set/Found (Procedure and Description)

AT CORNER FOUND A 2 3/8" BRASS CAP 3" DEEP BELOW GRADE, COUNTY SURVEY NO. 98-213-C & CORNER

FORM NO. Z23-98-213-C

FOUND A 5/8" IRON ROD W/YELLOW PLASTIC CAP 951 & UMATILLA MON. SIGN N 01°03' W 16.45', CORNER


FORM NO. Z23-98-213-C

FOUND A ALUMINUM TAG 951 ON POWER POLE N 87°02' W 285.25', CORNER FORM NO. Z23-98-213-C

FOUND A ALUMINUM TAG 951 ON POWER POLE N 84°22' E 262.30', CORNER FORM NO. Z23-98-213-C

FOUND A 5/8" IRON ROD W/YELLOW PLASTIC CAP 951 S 01°11' E 17.91', CORNER FORM NO. Z23-98-213-C

Sketch of Monument, Accessories and General Area

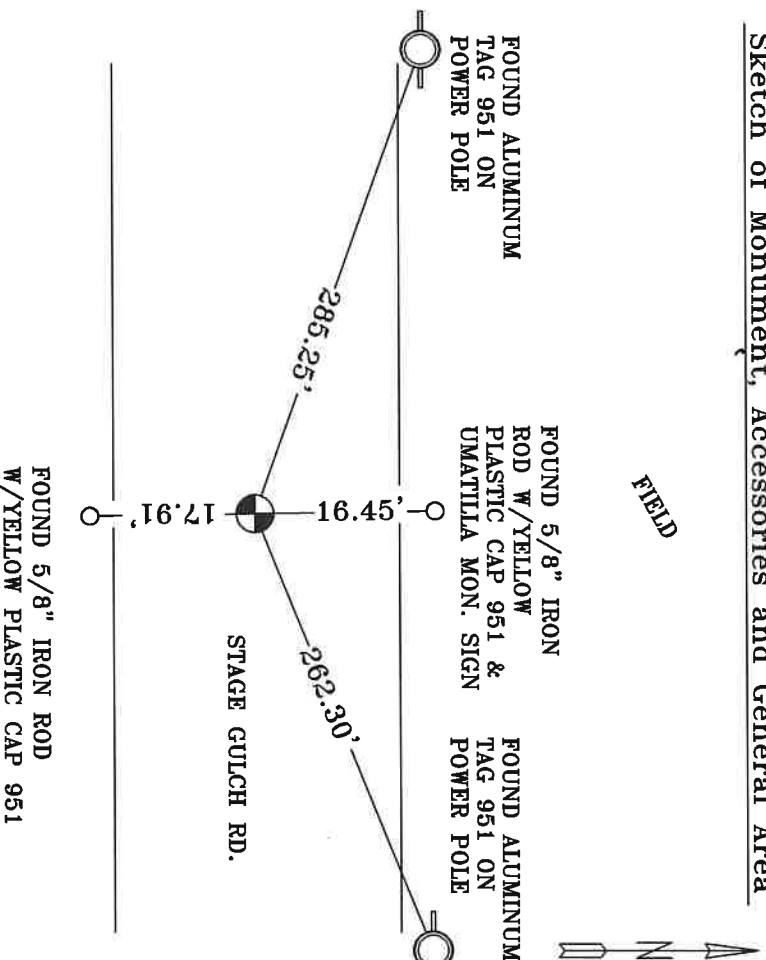

**REGISTERED
PROFESSIONAL
LAND SURVEYOR**

OREGON
MAY 10, 2011
LANCE CLARK KING
61420

RENEWALS: 6/30/2023

Agency: **CK3, LLC**
945 W. ORCHARD
HERMISTON OREGON 97838
OFFICE: 541-567-2345
FAX: 541-567-2305
WEB: CK3ILC.NET
Field Book # 0-350

COUNTY SURVEYOR
RECORDING INFO

Received CT

Filed 5/4/23

Survey No. Z3-042-C

Drawing No. _____

Index No. Z-23