

GPS CONTROL STATION

OREGON STATE PLANE, NORTH ZONE

STATION NAME: 3N29A5 GEODETIC COORDINATE: NAD 83(91)

SECTION: NW COR S5 LAT: 45°46'36.77665" N
T. 3N., R. 29 E., W. M. LONG: 119°13'32.13719" W
UMATILLA COUNTY
OREGON

STATE PLANE CO-ORDINATES,
NAD 83-91, INT. FT. :

DATE SURVEYED: March, 1998

N: 771908.506

SURVEYOR: DAVID L. HADDOCK
PLS 852

E: 8527253.238

THETA: 0°54'13.65"

SCALE FACTOR: 0.99995193

FIRM: HADDOCK SURVEYING
P. O. BOX 1574
PENDLETON, OR 97801
(541) 276-2174


ORTHO ELEV: 591

ELEV. DATUM: NGVD29

HORIZONTAL ORDER: SECOND ORDER,
CLASS I

LOCATION: From the Coe Street rail road crossing in the City of Stanfield go southwest on Seymour street across the Umatilla River until the road turns to the right heading due west. From this corner in the road go east along the fence just north of the irrigation ditch approximately 150 yards. The cap is under the fence just north of the irrigation headworks and about 20 feet west of a fence intersection.

STATION: Station is a 2 1/4 inch brass cap on a galvanized iron pipe. Cap is 2 inches above the surface of the ground.

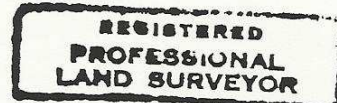

David L. Haddock

