

CORNER RESTORATION FORM

Township 3N & 4N Range 30E Section 1 & 36 County UMATILLA

State OREGON Date 3-11-2015 Number A-23

Corner Designation : 1/4 SECTION 1 & 36

Condition Report Only
 Not Found
 Renewed
 Surveyed In
 Referenced

Previous Renewals ORIGINAL SOURCE OF CORNER

UNDER GLO CONTRACT #84 BY N. GATES DATED


JULY 22, 1859 SET POST

Accessories Found:

NONE

MONUMENT DETAIL

Found Set

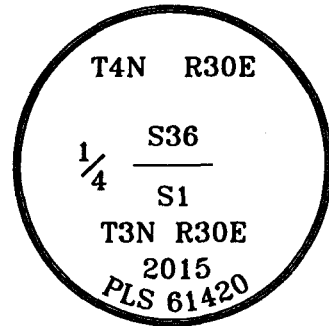

BASIS OF BEARINGS, NAD 83/91 OREGON STATE PLANE COORDINATES NORTH ZONE:

NORTHING: 773098.072
 EASTING: 8583344.234

Monument & Accessories Set (Procedure and Description)

- SET 2 1/2" BRASS CAP ON 1 1/4"x30" PIPE 0.5' ABOVE GRADE, NEXT TO WEST SIDE OF RAILROAD TIE, MARKER SIGN ON RAILROAD TIE.
- SET 5/8" REBAR & CAP PLS 61420 AT GRADE N42°20'E 33.11'.
- SET 5/8" REBAR & CAP PLS 61420 AT GRADE N87°06'E 21.69', IN FENCE LINE, BEARING OBJECT SIGN.
- SET 5/8" REBAR & CAP PLS 61420 AT GRADE, S0°45'E 24.31' IN FENCE LINE, BEARING OBJECT SIGN.
- SET 5/8" REBAR & CAP PLS 61420 AT GRADE, N67°55'W 13.21'.

Sketch of Monument, Accessories and General Area

SET 5/8" REBAR & CAP PLS 61420 AT GRADE
 N67°55'W 13.21'
 SET 5/8" REBAR & CAP PLS 61420 AT GRADE
 N42°20'E 33.11'
 SET 2 1/2" BRASS CAP ON 1 1/4"x30" PIPE 0.5' ABOVE GRADE, NEXT TO WEST SIDE OF RAILROAD TIE, MARKER SIGN
 EX. WIRE FENCE
 SET 5/8" REBAR & CAP PLS 61420 AT GRADE IN FENCE LINE, BEARING OBJECT SIGN
 N87°06'E 21.69'
 SET 5/8" REBAR & CAP PLS 61420 AT GRADE IN FENCE LINE, BEARING OBJECT SIGN
 S0°45'E 24.31'
 SET 5/8" REBAR & CAP PLS 61420 AT GRADE IN FENCE LINE, BEARING OBJECT SIGN
 GRASSY PASTURE

REGISTERED PROFESSIONAL LAND SURVEYOR

Lance Clark King

OREGON
MAY 10, 2011
LANCE CLARK KING
61420

RENEWS: 6/30/2015

Agency:
CK3, LLC
945 W. ORCHARD
HERMISTON OREGON 97838
OFFICE: 541-567-2345
FAX: 541-567-2305
WEB: CK3LLC.NET
Field Book # 0-289

COUNTY SURVEYOR RECORDING INFO

Received May Robert

Filed 6/12/2015

Survey No. 15-050-C

Drawing No. C-853

Index No. A-23