

CORNER RESTORATION FORM

Township 3N & 4N Range 30E Section 31,6,32&5 County UMATILLA

State OREGON Date 3-11-2015 Number A-5

Corner Designation : SECTION 31, 6, 32 & 5

- Condition Report Only
- Not Found
- Renewed
- Surveyed In
- Referenced

Previous Renewals ORIGINAL SOURCE OF CORNER

UNDER GLO CONTRACT #84 BY N. GATES DATED
JULY 22, 1859 SET POST

Accessories Found:


NONE

BASIS OF BEARINGS, NAD 83/91 OREGON STATE PLANE
 COORDINATES NORTH ZONE:

NORTHING: 772637.556
 EASTING: 8559388.513

MONUMENT DETAIL

Found Set

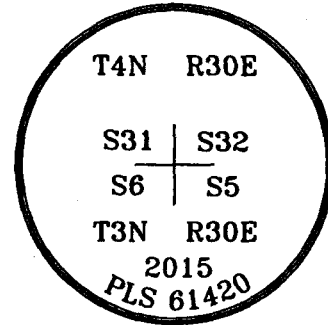

Monument & Accessories Set (Procedure and Description)

- SET 2 1/2" BRASS CAP ON 1 1/4"x30" PIPE 2' BELOW FIELD GRADE.
- SET 5/8" REBAR & CAP PLS 61420 AT GRADE, N78°51'E 171.39' IN FENCE LINE, BEARING OBJECT SIGN ON T-POST.
- SET 5/8" REBAR & CAP PLS 61420 AT GRADE, S49°46'E 132.22', IN FENCE LINE, BEARING OBJECT SIGN ON T-POST.
- SET 5/8" REBAR & CAP PLS 61420 1.3' BELOW GRADE, S24°10'W 186.10'.
- SET 5/8" REBAR & CAP PLS 61420 2' BELOW FIELD GRADE, N52°52'W 31.70'.

Sketch of Monument, Accessories and General Area

SET 5/8" REBAR & CAP PLS 61420 AT GRADE IN FENCE LINE, BEARING OBJECT SIGN

FIELD

SET 5/8" REBAR & CAP PLS 61420 2' BELOW FIELD GRADE

N52°52'W 31.70'

SET 2 1/2" BRASS CAP ON 1 1/4"x30" PIPE 2' BELOW FIELD GRADE

EX. WIRE FENCE

N78°51'E 171.39'

S49°46'E 132.22'

SET 5/8" REBAR & CAP PLS 61420 1.3' BELOW GRADE

S24°10'W 186.10'

EDGE OF FIELD

SET 5/8" REBAR & CAP PLS 61420 AT GRADE IN FENCE LINE, BEARING OBJECT SIGN

REGISTERED PROFESSIONAL LAND SURVEYOR

Lance Clark King

OREGON
 MAY 10, 2011
LANCE CLARK KING
 61420

RENEWS: 6/30/2015

Agency:
 CK3, LLC
 945 W. ORCHARD
 HERMISTON OREGON 97838
 OFFICE: 541-567-2345
 FAX: 541-567-2305
 WEB: CK3LLC.NET
 Field Book # 0-289

COUNTY SURVEYOR RECORDING INFO

Received *Mary Robert*

Filed 6/12/2015

Survey No. 15-050-C

Drawing No. C-853

Index No. A-5