

OREGON CORNER RESTORATION FORM

COUNTY: Umatilla DATE: 5/6/15

CORNER DESIGNATION: The North One-Quarter Corner of Section 4, Township 3 North, Range 31 East, A-11.

PREVIOUS RENEWALS/SURVEYS ETC.: Corner originally established by D.S. Payne, under Contract No. 100, dated 8/1/1861, notes state: Set charred stake with mound trench and pits as per instrs. for 1/4 sec corner.

MONUMENT AND ACCESSORIES FOUND: None.

MONUMENT MARKING DETAIL:

T4N R31E
1 S33
4 S4
T3N
2015
PLS 54657

MONUMENT SET:

Held North-South field berm for departure and reestablished corner on parallel of latitude between the Northwest and Northeast corners of Section 4. At reestablished corner point in North-South field berm in 4 foot high cut bank, 2 feet East of bottom of bank, set a 2 3/8" brass cap on a 1 1/4" x 30" galvanized iron pipe, with top 2" above ground surface, stamped as shown in "Monument Marking Detail".

From which:

A 5/8" x 24" rebar with a 1 1/4" purple plastic cap stamped "Wells Surveying PLS 54657", 2" above ground level in cut bank, bears North 02° East, 51.4 feet.

A 5/8" x 24" rebar with a 1 1/4" purple plastic cap stamped "Wells Surveying PLS 54657", 2" above ground level in cut bank, bears North 02° East, 26.3 feet.

A pink deep-1 magnet, 20" in the ground, bears South 30° East, 36.6 feet.

A blue deep-1 magnet, 20" in the ground, bears South 37° West, 28.1 feet.

Buried bearing object tags with magnets, wired bearing object tags to rebar, and set wood fence post with witness sign attached 1 foot North of monument.

LOCATION AND COMMENTS: At a calculated point in North/South field berm in 4 foot high cut bank, 2 feet East of bottom of bank.

OREGON STATE PLANE COORDINATE, North Zone, NAD 83(91), International Feet:


N = 773240.02
E = 8599358.55

FIRM: Wells Surveying
P.O. Box 1696
Pendleton, OR 97801

COMPASS DECLINATION: 18° East
Witnesses: Jason Wells, PLS
Dean Roy

Surveyor's Seal

/3N31A11

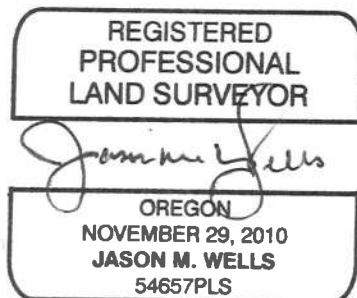

RENEWS: 6-30-16

15-052-C