

OREGON CORNER RESTORATION FORM

COUNTY: Umatilla DATE: 04/18/19

CORNER DESIGNATION: P-13, The East Quarter Corner of Section 21, Township 4 North, Range 32 East, W.M.

PREVIOUS RENEWALS/SURVEYS ETC.: Corner originally set by Odell and Lewis under Contract No. 110, dated February 7, 1865. Notes state: Set quarter section post drove charred post, dug pits-raised mounds per instructions.

MONUMENT AND ACCESSORIES FOUND: None. Held the intersection of farmed field berms extending West and South as best remaining evidence of the original corner. There is a power pole line in said field berms. The land owner indicated the pole line had been there since the 1950's and he thought there was a fence line as well. 1956 aerial photos clearly show the field berms extending West and South.

MONUMENT MARKING DETAIL:

T4N R32E
S21|S22
2019
PLS 54657

MONUMENT SET: At the corner point set a 2 3/8" dia. brass cap on a 1 1/4"x30" galvanized iron pipe with the top 22" below ground level in farmed field. Monument marked as shown in "Monument Marking Detail".

From which:

A silver Deep-1 magnet buried 22" below ground level in farmed field bears Grid Azimuth 59°14'24", 31.9 feet (ground distance).
A 5/8"x24" rebar with 1 1/4" blue plastic cap stamped "Wells Surveying PLS54657", 1" above ground level within 1 foot of a power pole in an unfarmed field corner bears Grid Azimuth 177°56'45", 33.1 feet (ground distance).
A 5/8"x24" rebar with 1 1/4" blue plastic cap stamped "Wells Surveying PLS54657", 1" above ground level within 1 foot of a power pole in an unfarmed field corner bears Grid Azimuth 267°27'24", 27.4 feet (ground distance).
A 5/8"x24" rebar with 1 1/4" blue plastic cap stamped "Wells Surveying PLS54657", 1" above ground level within 1 foot of a power pole bears Grid Azimuth 268°14'00", 352.5 feet (ground distance).

Buried bearing object sign with magnet. Wired bearing object signs to rebar. Set a steel fence post with Witness Post sign 3 feet South of Monument.


LOCATION AND COMMENTS: Corner is located at the intersection of farmed field berms extending South and West in a farmed area.

NAD 83(2011) EPOCH 2010.00, COORDINATES NORTH 786929.81, EAST 8633462.28

FIRM: Wells Surveying
P.O. Box 1696
Pendleton, OR 97801

COMPASS DECLINATION: 18° East

/4N32P13

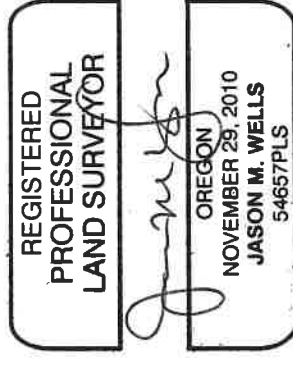

RENEWS: 6:30:20

19-039-8