

**OREGON CORNER RESTORATION FORM**

Section: 1, 6, 31, 36 Township: 3N, 4N Range: 32E, 33E  
County: Umatilla Date: 3/11/2011

Corner Designation: 3N33A01 (Amended 3/30/2012)

Township corner common to Sections 1, T3NR32E; 6, T3NR33E; 31, T4NR33E; 36, T4NR32E.

_____	Condition Report Only
X	Not Found
X	Remonumented
_____	Unrecorded
X	Surveyed In
X	Referenced Out


**Previous Renewals / Surveys, etc.**

Originally surveyed by Thompson in 1864. He set a post in a mound of earth. The N. P. Ry. "Wallula to Pendleton" Right of Way Plat, Umatilla County Railroad Map #131, shows the corner at 2,142.0' West of the track centerline. In 2002 Tomkins reestablished the corner by double proportionate method with best supporting evidence being an apparent old rail-bed more than 2,000' away. We do not accept this location as it places the corner 75', M/L, Northwest of the intersection of Midway Rd. and McCormmach Rd. This contradicts evidence in the Umatilla County Road Notes which places the corner at said intersection.


**Monuments and Accessories Found: (Condition and Source):**

None.

Diagram

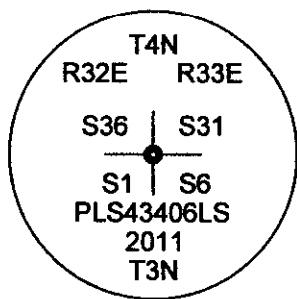

Sketch

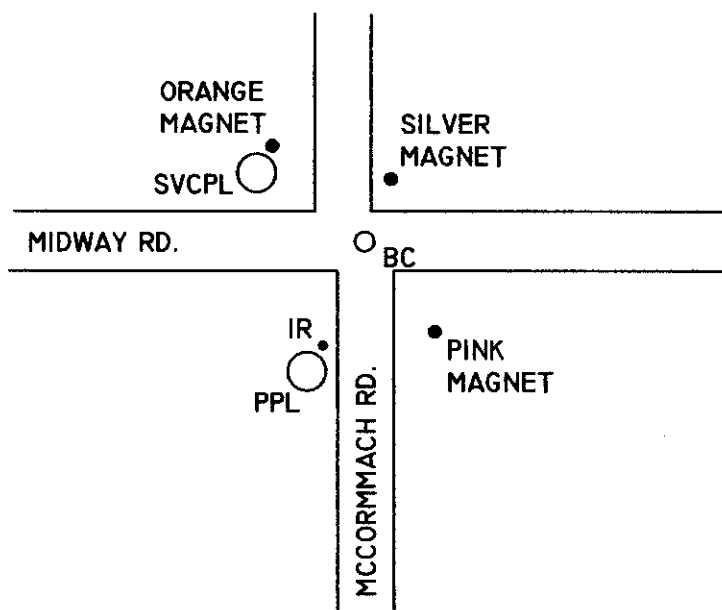

NAD 83/91  
OREGON STATE PLANE NORTH  
INTERNATIONAL FEET

N773881.48  
E8649783.62

**Monument(s) Set (Procedures and Description):**

A 1 1/8" x 30" galvanized iron pipe with a 2 1/2" brass cap, stamped as shown above, 1.2' below the surface of the road. Umatilla County Road Notes and calculated position both put the corner at the centerline intersection of McCormmach Rd. and Midway Rd. This provides a close fit to GLO records and the found evidence, fence posts on 1/2 mile interval, and is used as the reestablished corner location.

**References Set:**

- "Deep One" magnets by Berntsen.
- An orange magnet lies N 44° 10' W, 69.55', near a service pole, 1.6' deep.
- A silver magnet lies N 37° 40' E, 40.99', 1.8' deep.
- A pink magnet lies S 38° 10' E, 59.12', 1.7' deep.
- A 5/8" x 30" iron rebar w/ RPC #43406 lies S 24° 40' W, 49.07', at a power pole.

**Location and Comments:**

The corner is located at the intersection of Midway Rd. and McCormmach Rd.

**Compass Declination**

17° E

**Surveyors Seal**

REGISTERED  
PROFESSIONAL  
LAND SURVEYOR

*Robert D. English*  
OREGON  
JANUARY 11, 2005  
ROBERT DOUGLAS ENGLISH  
43406LS

RENEWAL DATE: 12/31/13

**RECEIVED BY:**

Date: 7/10/2012  
Rec'd By: S. [Signature]  
No. 12-094-C

**Firm / Agency**

Survey One, LLC.  
P.O. Box 382  
Pendleton, OR 97801  
(541) 276-2055