

OREGON CORNER RESTORATION FORM

Section 2 Township 4N Range 33E
 County Umatilla Date: January 7, 2000

Corner Designation: 4N33E17

Corner for Sectins 2, 3, 10 and 11,
 T4N, R33E, W.M.


Condition Report Only
 Not found
 Remonumented
 Unrecorded
 Surveyed in
 Referenced out

Previous Renewals / Surveys, etc.

Corner originally surveyed and set by Odell and Lewis under contract #110,
 dated February 7, 1865.

Their record reads: Set post, cor. for secs. 2, 3, 10 and 11. Drove charred stake, dug
 pits, and raised mound.

Monument and Accessories found: (condition and source)
 None.

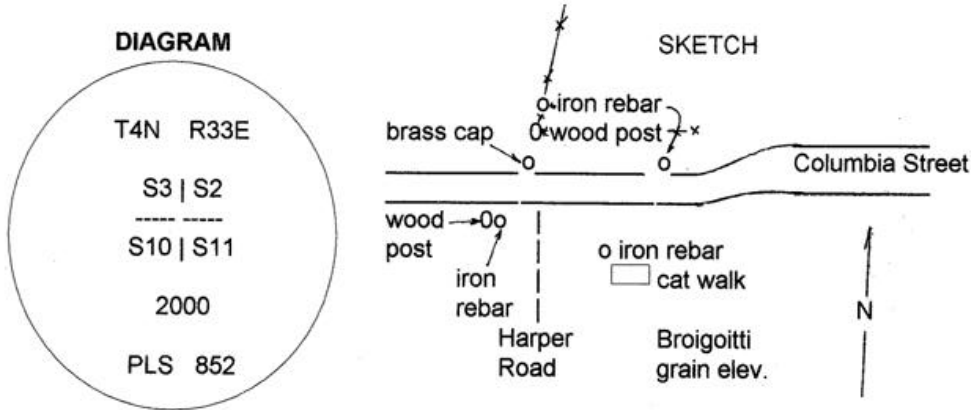

MONUMENT (S) AND ACCESSORIES SET (Procedures and Description)

At the intersection of the centerline of Columbia Street (as projected through monuments at it's intersections with Solar and Cleveland in Helix) with the centerline of Harper Road, I set a 2.25" brass cap stamped as shown in the diagram above, 1' below the north shoulder.

REFERENCES SET:

I set 4 - 5/8" x 24" iron rebars with 1.25" plastic caps stamped ORLS 852 and WALS 13922 as described below:

- An iron rebar bears N6°40'32"E, 39.72 feet with the plastic cap flush with the ground surface.
- An iron rebar bears S89°34'00"E, 149.59 feet with the plastic cap 6" below the north road shoulder.
- An iron rebar bears S35°57'W, 48.26 feet with the plastic cap flush with the ground surface at the base of a wood post.
- An iron rebar bears S60°02'E, 117.43 feet with the plastic cap flush with the ground surface at the northwest corner of a cat walk structure.

Location and comments
 On the north shoulder of Columbia Street at the intersection with Harper Road.

Compass Declination
 20° west

Surveyors Seal

Firm / Agency
 Haddock Surveying
 Address
 P.O. Box 1574
 Pendleton, Or. 97801
 Party Chief
 David L. Haddock

REGISTERED
 PROFESSIONAL
 LAND SURVEYOR

David L. Haddock

OREGON
 JULY 12, 1988
 DAVID L. HADDOCK
 852

RECEIVED BY:
Umatilla County Surveyor
 Date: _____
 Rec'd By: _____
 No. 99-229-B