

OREGON CORNER RESTORATION FORM

COUNTY: Umatilla DATE: 02/03/16

CORNER DESIGNATION: E-9, The Northwest Quarter Corner of Section 9, Township 4 North, Range 33 East, W.M.

PREVIOUS RENEWALS/SURVEYS ETC: Corner originally established by Odell & Lewis under Contract No. 110 dated February 7th, 1865. Set post corner for sections 4, 5, 8 & 9. Drove charred stake, dug pits, and raised mound as per instructions. Old County Road surveys passed through the corner but there are no usable corner ties.

MONUMENT AND ACCESSORIES FOUND: None. Held East-West centerline of Holdman Road at it's intersection with an old field berm extending North as best available evidence of the original corner point. Verified corner point position by survey ties to corner evidence 1/2 mile East and West of corner point. See 2016 Jim Williams Partition Plat for reference.

MONUMENT MARKING DETAIL:

T4N R33E
S5 | S4
S8 | S9
2016
PLS 1106

MONUMENT SET: At reestablished corner point, set a 5/8" x 30" iron rebar with a 2" aluminum cap, 1" below road surface, marked as shown in "Monument Marking Detail".

New Accessories:

A 5/8" x 24" iron rebar with a red plastic cap stamped "OR PLS 1106, WA PLS 17372", 1" above ground level, in road bank, bears Grid Azimuth 64°56', 48.9 feet, set steel fence post with witness sign 1.0 feet North of rebar.

A 5/8" x 30" iron rebar with a red plastic cap stamped "OR PLS 1106, WA PLS 17372", flush with ground, in farmed field ("witness" corner for NE Corner of Parcel 1), bears Grid Azimuth 188°13', 30.5 feet, (S 09°30'30" W, 30.47' computed from Partition Plat).

A 5/8" x 24" iron rebar with a red plastic cap stamped "OR PLS 1106, WA PLS 17372", flush with ground on East edge of gravel drive at start of road ditch, bears Grid Azimuth 255°07', 70.4 feet.

A 5/8" x 24" iron rebar with a red plastic cap stamped "OR PLS 1106, WA PLS 17372", flush with ground in road bank, bears Grid Azimuth 284°51', 60.9 feet.

Wired bearing object tags to all rebar except the Southeast one (wired bearing object tag to steel fence post set beside property corner "witness" monument).

LOCATION AND COMMENTS: Corner is located in centerline of paved Holdman Road, East-West with intersection of old field berm extending North.

OREGON STATE PLANE COORDINATE, North Zone, Datum Realization NAD 83(2011), epoch 2010.00 per ORGN Real-Time Network observation in International Feet:

N = 800866.3

E = 8659493.4

FIRM: Wells Surveying

P.O. Box 1696

Pendleton, OR 97801


COMPASS DECLINATION: 18° East

Surveyor's Seal


Witnesses: Jason Wells, PLS

Dean Roy

\4N33E9

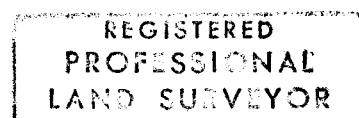

William R. Wells

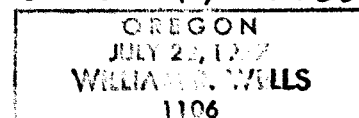

renews 6-30-15

16-038-R