


CERTIFIED RECORD OF LAND CORNER MONUMENTATION

DIAGRAM

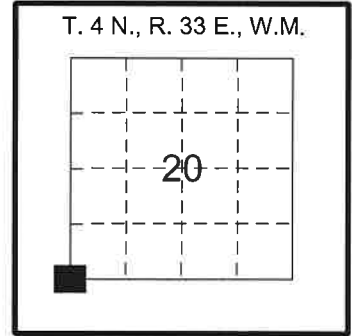

R-5

HISTORY OF ORIGINAL CORNER ESTABLISHMENT:

THIS CORNER WAS ORIGINALLY ESTABLISHED BY GENERAL LAND OFFICE SURVEYORS ODELL & LEWIS UNDER CONTRACT NO. 110 DATED FEBRUARY 7, 1865.

SURVEYOR GENERAL LAND OFFICE FIELD NOTES STATE:
 "SET POST CORNER FOR SECTIONS 19, 20, 29, & 30,
 DROVE CHARRED STAKE, DUG PITS & RAISED MOUNDS
 AS PER INSTRUCTIONS"

DESCRIPTION OF CORNER EVIDENCE FOUND:

NO ORIGINAL EVIDENCE OF THE MONUMENT OR ITS ACCESSORIES WAS FOUND.

A 3/4" IRON ROD WAS FOUND ON THE NORTHERLY RIGHT OF WAY LINE OF ATHENA - HOLDMAN HIGHWAY. THE ATHENA - HOLDMAN HIGHWAY IS SHOWN ON STATE HIGHWAY DRAWING 6B-16-17 AS BEING ESTABLISHED ON THE SECTION LINE BETWEEN SECTIONS 20 & 29. SAID 3/4" IRON ROD TOGETHER WITH THE METAL FENCE POSTS FOUND ALONG THE WEST LINE OF SECTION 20 AND THE CENTER OF THE EXISTING PAVEMENT OF THE ATHENA - HOLDMAN HIGHWAY WERE ALL HELD TO ESTABLISH THE SOUTHWEST CORNER OF SECTION 20.

DESCRIPTION OF MONUMENT AND ACCESSORIES ESTABLISHED TO PERPETUATE THE ORIGINAL LOCATION OF THIS CORNER:


ESTABLISHED THE CORNER AS SHOWN ON THE RECORD OF SURVEY FOR THE MYRICK STOCKPILE BOUNDARY SURVEY FILED CONCURRENTLY WITH THIS CORNER MONUMENTATION RECORD.

SET 3-1/4" ALUMINUM CAP ON A 5/8" X 30" IRON ROD IN MONUMENT BOX.

THE CAP IS MARKED AS SHOWN BELOW.

THE REFERENCES SET FOR SAID CORNER ARE AS FOLLOWS:

- 1) A 5/8" X 30" IRON ROD WITH A 1-1/2" ALUMINUM CAP STAMPED "ODOT" BEARS N33°06'41"W, 34.96 FEET.
- 2) A 5/8" X 30" IRON ROD WITH A 1-1/2" ALUMINUM CAP STAMPED "ODOT" BEARS N36°30'08"E, 33.59 FEET.
- 3) A 5/8" X 30" IRON ROD WITH A 1-1/2" ALUMINUM CAP STAMPED "ODOT" BEARS S39°37'45"E, 34.09 FEET.
- 4) A 5/8" X 30" IRON ROD WITH A 1-1/2" ALUMINUM CAP STAMPED "ODOT" BEARS S68°19'48"W, 47.91 FEET.

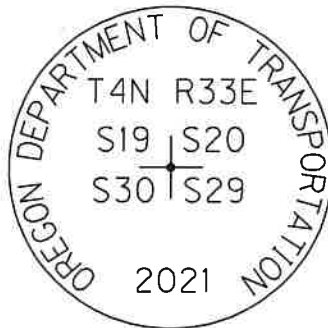

WITNESSES:
 BRENT REYNOLDS, TRAVIS COFFELT

REGISTERED
 PROFESSIONAL
 LAND SURVEYOR

BRENT REYNOLDS

OREGON
 JAN 14, 2003
 BRET N. ELITHORP
 61348

I HEREBY CERTIFY THAT THE ABOVE CORNER POSITION WAS RE-ESTABLISHED AS HEREON DESCRIBED ON APRIL 22, 2021.

EXPIRES: 12/31/2021



OREGON DEPARTMENT
 OF TRANSPORTATION
 REGION 5
 SURVEY
 UNIT

Section	MYRICK STOCKPILE		
Highway	ATHENA HOLDMAN HIGHWAY		
County	UMATILLA	Scale	NTS
Purpose	BOUNDARY SURVEY	Date	MAY 5, 2021

21-059-6