

OREGON CORNER RESTORATION FORM

Section: 4, 33 Township: 3N, 4N Range: 33E
County: Umatilla Date: 3/24/2011

Corner Designation: 3N33A11

Quarter corner common to Sections 4, T3NR33E; 33, T4NR33E.

- Condition Report Only
- Not Found
- Remonumented
- Unrecorded
- Surveyed In
- Referenced Out


Previous Renewals / Surveys, etc.

Originally surveyed by Thompson in 1864. He set a post in a mound of earth with charred stake, pits, and trench. In 2005 Flowers set an unrecorded brass cap.


Monuments and Accessories Found: (Condition and Source):

A 2 1/2" brass cap, stamped as shown below, 14" below the surface
A 5/8" iron rebar w/RPC #2820 lies S 2° E, 30.06', with a steel fence post.

Diagram

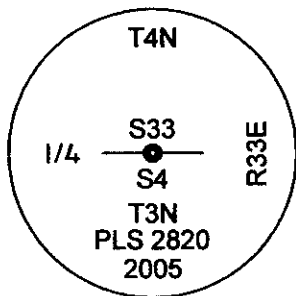

Sketch

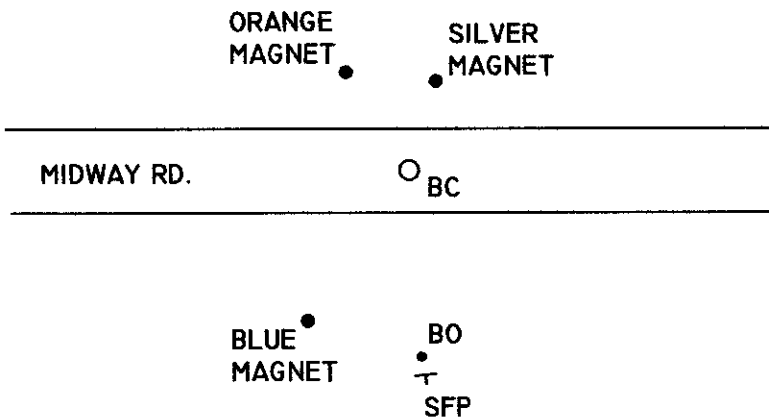

NAD 83/91
OREGON STATE PLANE NORTH
INTERNATIONAL FEET

N774145.83
E8662754.21

Monument(s) Set (Procedures and Description):

None.

References Set:

"Deep One" magnets by Bermtsen.
An orange magnet lies N 43° 20' W, 26.37', 1.6' deep.
A silver magnet lies N 25° 30' E, 22.88', 1.5' deep.
A blue magnet lies S 42° W, 29.57', 1.6' deep.

Location and Comments:

The corner is located 1/2 mile West of the intersection of Midway Rd. and Molstrom Rd.

Compass Declination

17° E

Surveyors Seal

REGISTERED
PROFESSIONAL
LAND SURVEYOR

Robert D. English
OREGON
JANUARY 11, 2005
ROBERT DOUGLAS ENGLISH
43406LS

RECEIVED BY:

Date: 7/10/2012
Rec'd By: S. Alex
No. 12-094-C

Firm / Agency

Survey One, LLC.
P.O. Box 382
Pendleton, OR 97801
(541) 276-2055

RENEWAL DATE: 12/31/13