

OREGON CORNER RESTORATION FORM

Section: 5, 32 Township: 3N, 4N Range: 33E
County: Umatilla Date: 3/11/2011

Corner Designation: 3N33A07 (Amended 3/30/2012)

Quarter corner common to Sections 5, T3NR33E; 32, T4NR33E.

_____	Condition Report Only
X	Not Found
X	Remonumented
_____	Unrecorded
X	Surveyed In
X	Referenced Out


Previous Renewals / Surveys, etc.

Originally surveyed by Thompson in 1864. He set a post in a mound of earth with charred stake, pits, and trench.


Monuments and Accessories Found: (Condition and Source):

None.

Diagram

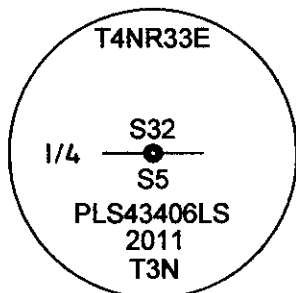

Sketch

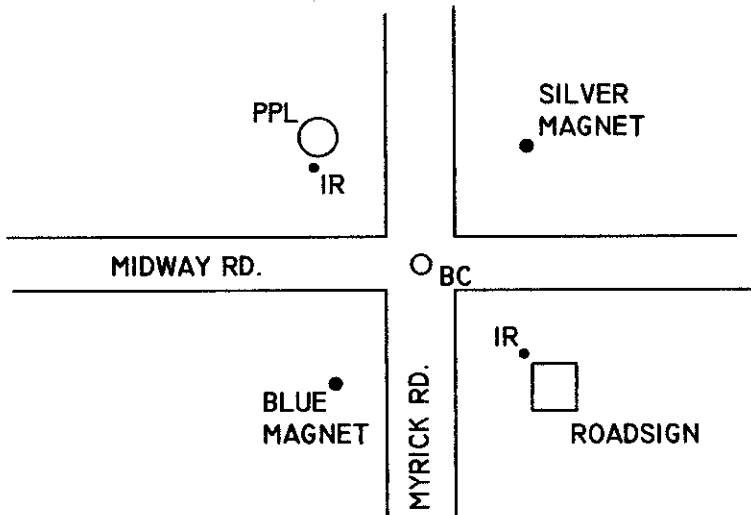

NAD 83/91
OREGON STATE PLANE NORTH
INTERNATIONAL FEET

N774015.78
E8657469.20

Monument(s) Set (Procedures and Description):

A 1 1/8" x 30" galvanized iron pipe with a 2 1/2" brass cap, stamped as shown above, 1.5' below the surface of the road. Held intersection of road centerlines as best evidence of the original corner location, as referenced in Umatilla County Road Notes.

References Set:

- "Deep One" magnets by Berntsen.
- A 5/8" x 30" iron rebar w/RPC #43406 lies N 48° 10' W, 37.47', at a power pole.
- A silver magnet lies N 42° 10' E, 42.72', 1.7' deep.
- A 5/8" x 30" iron rebar w/RPC #43406 lies S 48° 50' E, 35.89', at a road sign.
- A blue magnet lies S 36° 20' W, 38.65', 1.7' deep.

Location and Comments:

The corner is located at the intersection of Midway Rd. and Myrick Rd.

Compass Declination

17° E

Surveyors Seal

REGISTERED
PROFESSIONAL
LAND SURVEYOR

Robert Douglas English
OREGON
JANUARY 11, 2005
ROBERT DOUGLAS ENGLISH
43406LS

RECEIVED BY:

Date: 7/10/2012
Rec'd By: [Signature]
No. 12-094-C

Firm / Agency

Survey One, LLC.
P.O. Box 382
Pendleton, OR 97801
(541) 276-2055

RENEWAL DATE: 12/31/13