

**OREGON CORNER RESTORATION FORM**

Section: 4, 5, 32, 33      Township: 3N, 4N      Range: 33E  
County: Umatilla      Date: 3/24/2011

Corner Designation: 3N33A09

Section corner common to Sections 4, 5, T3NR33E; 32, 33, T4NR33E.

	Condition Report Only
X	Not Found
X	Remonumented
	Unrecorded
X	Surveyed In
X	Referenced Out


**Previous Renewals / Surveys, etc.**

Originally surveyed by Thompson in 1864. He set a post in a mound of earth with charred stake, pits, and trench.


**Monuments and Accessories Found: (Condition and Source):**

None.

Diagram

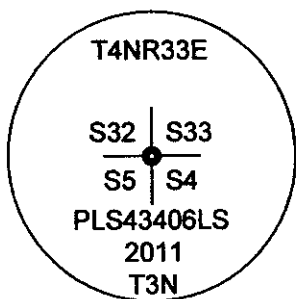

Sketch

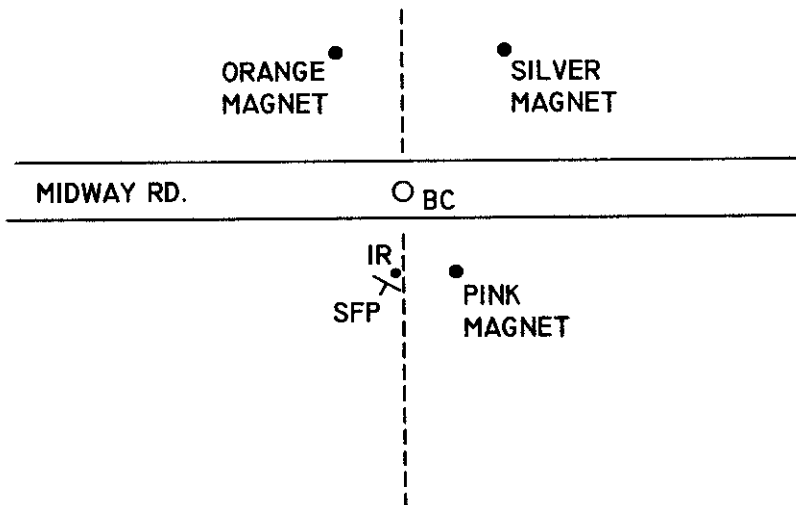

NAD 83/91  
OREGON STATE PLANE NORTH  
INTERNATIONAL FEET

N774080.86  
E8660113.52

**Monument(s) Set (Procedures and Description):**

A 1 1/8" x 30" galvanized iron pipe with a 2 1/2" brass cap, stamped as shown above, 1.0' below the surface. The corner location was reestablished at the intersection of the line between neighboring corners East and West and the projection of field lines from the North and South and from old fence corner posts to the South.

**References Set:**

- "Deep One" magnets by Bermtsen.
- An orange magnet lies N 29° 40' W, 33.06', 1.5' deep.
- A silver magnet lies N 28° 40' E, 34.39', 1.4' deep.
- A pink magnet lies S 40° 10' E, 17.52', 1.6' deep.
- A 5/8" x 30" iron rebar w/ RPC #43406 lies S 3° W, 16.74', with a steel fence post.

**Location and Comments:**

The corner is located 1/2 mile East of the intersection of Midway Rd. and Myrick Rd.

**Compass Declination**

17° E

**Surveyors Seal**

REGISTERED  
PROFESSIONAL  
LAND SURVEYOR

*Robert D. English*  
OREGON  
JANUARY 11, 2005  
ROBERT DOUGLAS ENGLISH  
43406LS

RENEWAL DATE: 12/31/13

**RECEIVED BY:**

**Firm / Agency**

Date: 7/10/2012  
Rec'd By: [Signature]  
No. 12-094-C

Survey One, LLC.  
P.O. Box 382  
Pendleton, OR 97801  
(541) 276-2055