

OREGON CORNER RESTORATION FORM

Section 5 Township 4N Range 36E
 County Umatilla Date: 9-Jan-26

Corner Designation: 4N36A5

Condition report only

Closing corner to Sections 5 and 6, T4N, R36E, W.M.,
 Umatilla County, Oregon.

Remonumented
 Unrecorded
 Surveied In
 Referenced Out


Previous Renewals, Surveys, etc...

This corner was originally set by William Odell under Contract No. 114, Dated July 2nd, 1866.

His record reads: Set closing cor. for Secs. 5&6. deposited basalt stone and made stone mound as per instructions. In 1885 under the Record of Private Surveys, Book 1, Survey 11B, Deputy County Surveyor John Arnold says: Set a basalt stone 18x9.5x6 ins. marked with 6 notches on E. edge and CC on S.W. face in stone mound with original government stake.

Monument and accessories found: (condition and source)

Found the stone by Arnold clearly marked as stated set firmly in a 2 ft. diam. stone mound.

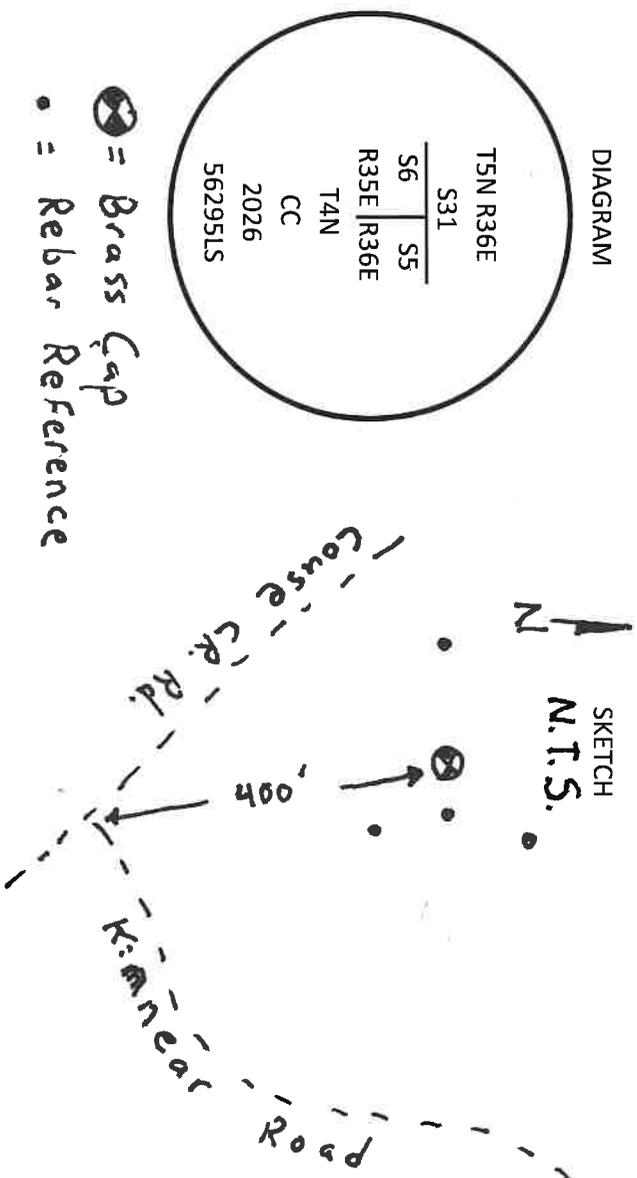

⊗ = Brass Cap
 • = Rebar Reference

MONUMENT(S) AND ACCESSORIES SET (Procedures and Description)

At the position of the stone I set a 2 1/2" brass cap on a 1 1/2" x 30" galvanized iron pipe 24 inches in the ground to bedrock. I build a 2 ft. diameter collar of stone around the monument. I buried the stone on its side along the north side of the monument. I set a 6 foot steel post with a County Monument sign approximately 2 feet north of the brass cap.

For references I set four 5/8" by 24" iron rebars with 1.25" orange plastic caps stamped WTS and 56295LS as described below:

- An iron rebar bears N32°42'33"E 74.46 feet flush with the surface;
- An iron rebar bears S85°36'26"E 21.74 feet flush with the surface;
- An iron rebar bears S62°22'21"E 82.05 feet flush with the surface;
- An iron rebar bears S89°50'28"W 47.99 feet flush with the surface;

Measurements were made with a Trimble R8S base/rover RTK GPS system.

Location and comments:
 Approximate coordinates:
 Latitude =
 Longitude =
 RECEIVED BY:
 Umatilla County Surveyor
 Date: 3/17/26
 Rec'd By: CT
 No. 26-022-R

Compass Declination
 Firm / Agency
 Witness Tree Surveying
 Address
 P.O. Box G
 Pilot Rock, OR 97868
 Party Chief
 Stephen K. Haddock

Surveyor's Seal



RENEWALS: 6-30-27