

OREGON CORNER RESTORATION FORM

Section 5 Township 4N Range 36E
 County Umatilla Date: January 9th, 2026

Corner Designation: 4N36E5

Condition report only

Not Found

Corner to Sections 5, 6, 7, and 8, T4N, R36E, W.M.,
 Umatilla County, Oregon.


Remonumented
 Unrecorded
 Surveied In
 Referenced Out

Previous Renewals, Surveys, etc...


This corner was originally set by William H. Odell under Contract No. 114, Dated July 2nd, 1866. His Record Reads: Set post cor. for Secs. 5, 6, 7, and 8. Drove charred stake, dug pits, and raised mound As per instructions. Deputy County Surveyor John Arnold, in the Record of Private Surveys Book 1, Survey 11B, found a mound and three plain pits. This point was accepted based on the testimony of the landowners present and a basalt stone 20x6x4 ins. with 5 notches on the south edges was set.

Monument and accessories found: (condition and source)

The remains of an old East - West fence line with a newer fence built several feet to the north of the old location. Most of the field berm from the old fence has been leveled and there are several mounds of field stones newly deposited in the area.

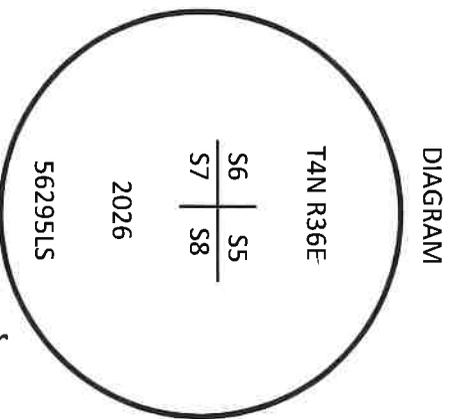

DIAGRAM

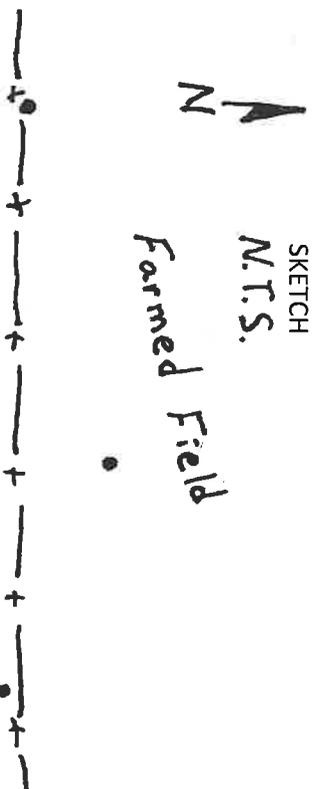

SKETCH

- ⊗ = Brass Cap
- = Rebar Reference

MONUMENT(S) AND ACCESSORIES SET (Procedures and Description)

I held the location of the old fence remains for latitude and prortioned the departure based on found acceptable corner evidence of the 1/4 corners to the east and west.

For references I set four 5/8" by 24" iron rebars with 1.25" orange plastic caps stamped WTS and 562951S as described below:

- An iron rebar bears N4°48'07"W 19.04 feet. The cap is 12 inches below the surface;
- An iron rebar bears N84°09'56"W 34.05 feet flush with the surface under the new fence;
- An iron rebar bears S00°54'34"E 17.77 feet. The cap is 12 inches below the surface;
- An iron rebar bears N76°31'09"E 18.77 feet flush with the surface under the new fence;

The monument was referenced and reset using a Trimble R8S Base/Rover RTK GPS system.

Location and comments:

Compass Declination

Surveyor's Seal

RECEIVED BY:

Umatilla County Surveyor


Date: 5/17/26

Rec'd By: CT

No. 26-022-R

Firm / Agency
 Witness Tree Surveying
 Address

P. O. Box G
 Pilot Rock, OR 97868
 Party Chief
 Stephen K. Haddock

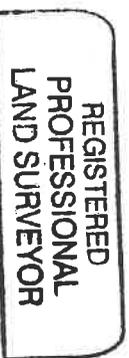

Stephen K. Haddock

OREGON
 JULY 9, 2001
 STEPHEN K. HADDOCK
 562951S

RENEWALS: 6-30-27