

OREGON CORNER RESTORATION FORM

COUNTY: Umatilla. DATE: 10/18/19.

CORNER DESIGNATION: R-11, The North 1/4 corner of Section 28, Township 4 North, Range 36 East, W.M.

PREVIOUS RENEWALS/SURVEYS ETC: Corner was originally established by William H. Odell, Deputy Surveyor, under Contract No. 114, dated July 2, 1866. Notes state:

Set post Cor. For 1/4 Sec., from which:

A Pine, 12 ins. diam. brs. N 40° E., 155 lks.

A Pine, 20 ins. diam. brs. S 8° W., 125 lks.

MONUMENT AND ACCESSORIES FOUND: A locust post fence corner with fence line extending South and West.

MONUMENT MARKING DETAIL:

T4N R36E
S21
1/4 -----
S28
2019
PLS 1106

NAD 83 (2011) epoch 2010.00 Coordinates
International feet units:
N: 785908.25
E: 8756525.85

MONUMENT SET: At a point just North of the old locust post fence corner, set a 2 1/2 brass cap on 1 1/4 by 30" galvanized iron pipe 25" in the ground. Cap is marked as shown in "Monument Marking Detail".

New accessories:

A 4" Ponderosa Pine bears N 04° E, 54.5' scribed X at breast height and BT at base of tree.

A 8" Ponderosa Pine bears S 53° E, 12.3' scribed 1/4 S28 BT.

A 6" Ponderosa Pine bears S 26° W, 72.7' scribed 1/4 S28 BT.

A 5/8 by 24" rebar with 1 1/4" red plastic cap bears N 85° W, 18.1', set at South base of round wood post in fence line extending West.


Attached bearing tree signs to the new bearing trees and wired sign to rebar accessory. Red plastic cap is marked "OR PLS 1106 WA PLS 17372".

Nailed a "witness" sign to locust post by the corner monument.


LOCATION AND COMMENTS: Corner is located at fence corner West of a dirt road which turns East near the corner monument. Used Spencer tape and compass with 14° East declination to measure corner accessories.

FIRM: Wells Surveying
P.O. Box 1696
Pendleton, OR 97801

Surveyor's Seal

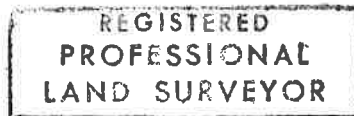

William R. Wells

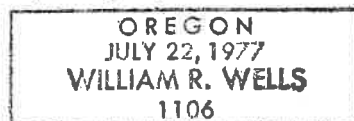

renews 6-30-20

4N36R-11

20-025-R