

USDA-FOREST SERVICE

Index
File No. J-17

CORNER RECORD (SEARCH)
(Ref. FSM 7151.4)

Tract or Survey No. 0 Cor. No. J-17


T 4 N R. 37 E

R.D. _____ County _____

Merid. _____

N.F. _____ State _____

CORNER DIAGRAM

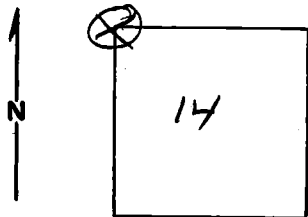

DESCRIBE CORNER MONUMENT FOUND

County Record \leq Line #1
(?) Drawing # 1121, 1124.
Newbill-1956,

DESCRIBE BEARING TREES OR OTHER OFFICIAL ACCESSORIES FOUND

Which corner was found??

offset corners. D. Gaylord 12/83
(assume Ball)

PHOTO IDENTIFICATION DATA

Photo No. _____
Filed At. _____
Object Ident. _____
Ident. By _____

DESCRIBE CORNER LOCATION RELATIVE TO NEAR-BY FEATURES, ALSO HOW TO REACH CORNER.

510 / 511 MONUMENTED BY BILL WELLS, 1994.
515

PLANE COORDINATE POSITION DATA

State _____ Zone _____
X _____
Y _____
Estab. By _____
Agency

Signature

TGN

Title

Division

Headquarters

Date

2-5-79

7100-52-(3/68)

CORNER RECORD (PERPETUATION)

MONUMENT: DESCRIBE NEW MONUMENT SET, OR WORK DONE TO PRESERVE EXISTING MONUMENT

ACCESSORIES : DESCRIBE NEW BT'S WITNESS OBJECTS ETC. ESTABLISHED, OR WORK DONE TO PRESERVE EXISTING EVIDENCE

Work Done By _____ Title _____ Date _____ State Registration No. or Agency _____
Certified Cor. Record Prepared ? Yes No Filed At: _____ Date _____

REMARKS

Index File No. T. R. M. Tract or Surv. No. Cor. U.S. G.P.O. 1977-725-576/586