


CERTIFIED RECORD OF LAND CORNER MONUMENTATION

HISTORY OF ORIGINAL CORNER ESTABLISHED:

Corner not previously established.

T 4 N R 37 E V-14

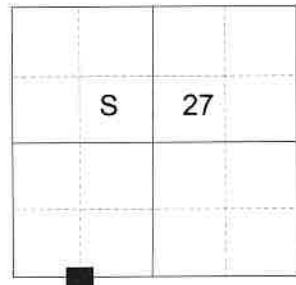

DESCRIPTION OF CORNER EVIDENCE FOUND:

Found remnants of barb wire fence corner to North and East bearing fence lines approx. 5' East of surveyed corner.

SEE SURVEY FOR HANCOCK FOREST MANAGEMENT DATED AUG 2020

DESCRIPTION OF MONUMENT AND ACCESSORIES I ESTABLISHED TO MONUMENT THE ORIGINAL LOCATION OF THIS CORNER:


At position by survey, I set a 5/8" x 30" iron pin, 29" in the ground with 2 1/2" aluminum cap marked as shown below,
from which:

NEW BEARING OBJECTS:

A 6" double bole Spruce bears North 31° East, a dist. of 6.90 ft., marked W 1/16 S27 BT (scribe is on the Eastern most bole).
A 6" White Fir bears South 51° East, a dist. of 10.85 ft., marked W 1/16 S34 BT.

Set steel fence post approx. 0.5 ft. East.

I hereby certify that the corner was monumented on August 19, 2020.
Witness: Kyle A. Tucker

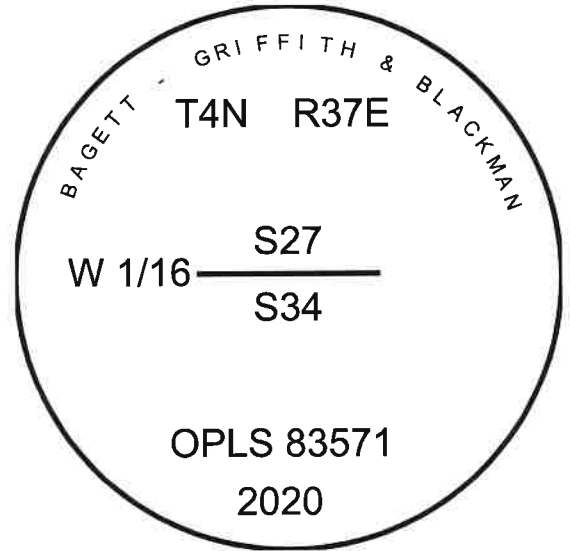

Renewal Date: June 30, 2021

I used a steel tape and magnetic compass in the establishment of the new accessories. I used 14° East declination, the distance is to a 60d spike driven into the right side of the root crown of the bearing tree. A brass washer marked OPLS 83571 is attached to the BT blaze of the new bearing tree.

20-072-6